


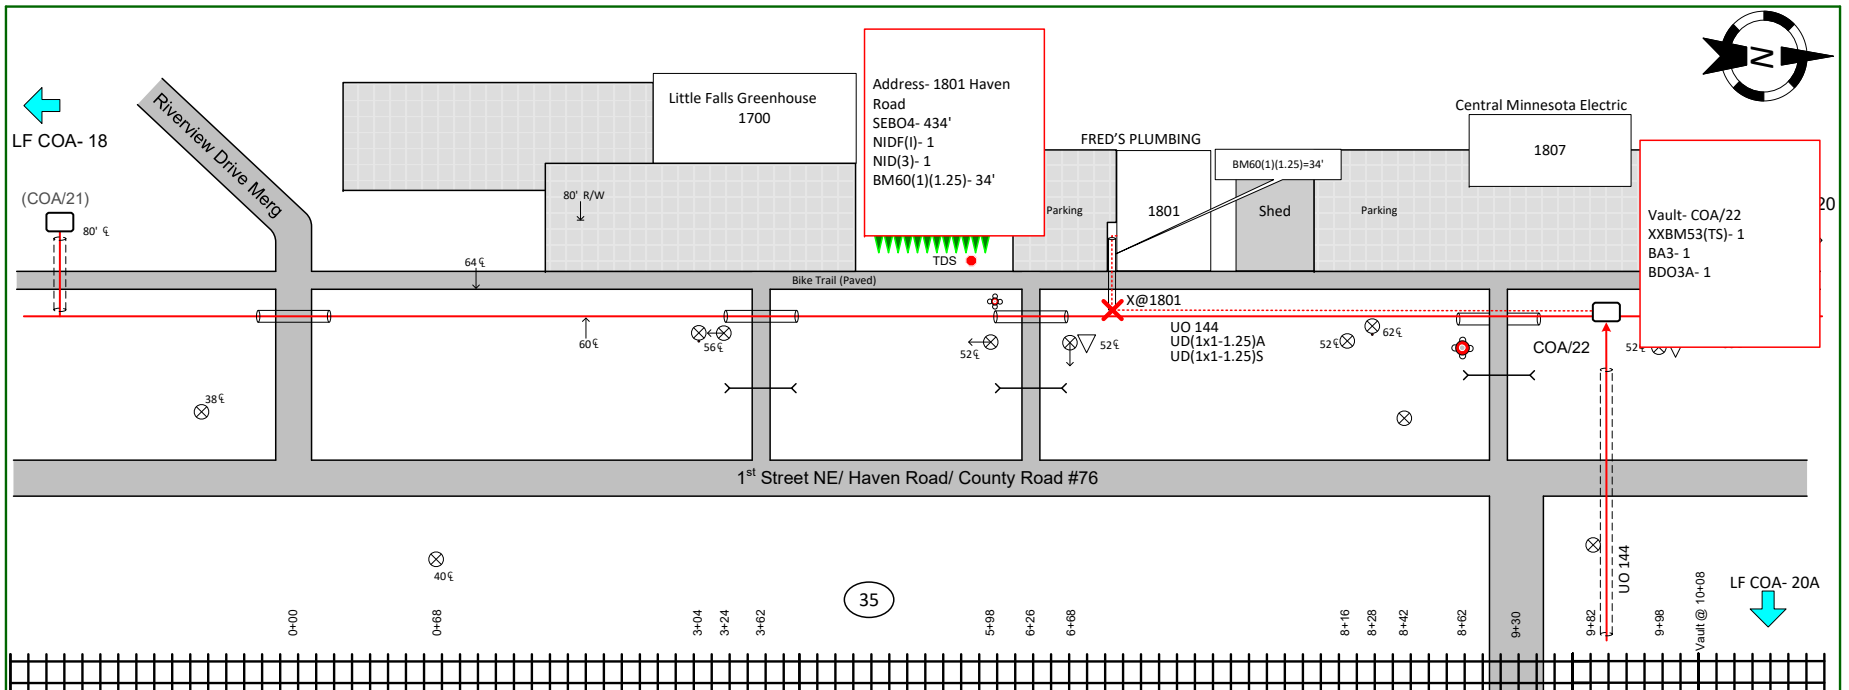

From	To	PType	Units	Feet	BHF	BM	HB	HO	Remarks
(COA/21)	COA/22	BHF(30x48x36)T	UO 144	1300	(30x48x36)T	1	2(5/8)(8)	1	FO(144)(M)
	COA/22		UD(1x1-1.25)A	320					
	COA/22		UD(1x1-1.25)S	750					

As Built Consolidated Telephone Company

Name: LF COA- 19
 WO: LittleFalls-2013 Mainline
 Exch: CLEC
 Route: COA
 ROW: 80'
 State: Minnesota
 County: Morrison
 Range: 32W
 Twsp: 41N Section: 35
 Township: City of Little Falls

Staked By: EMD Date: 1-16-12
 Revised By: RE Date: _____
 Revised By: _____ Date: _____
 Revised By: _____ Date: _____
 As-Built By: CLP Date: 12/4/13