


From	To	PType	Units	Feet	BA	BM	HO	Remarks	CTC	As Built
(PON 1: 1C/14)	PON 1: 1C/15	BDO5(AGS)	BFO 72	2722	3	1	2(5/8)(8)	1	1C-11	Consolidated Telephone Company
	PON 1: 1C/15					53A	1		WO: 2016 CTC	
PON 1: 1C/15	PON 1: 1C/16	BDO5(AGS)	BFO 72	566	3	1	2(5/8)(8)	1	Exch: Randall	Route: 1C
	PON 1: 1C/16					53A	1		ROW: Public	
PON 1: 1C/16	PON 1: 1C/17	BDO5(AGS)	BFO 72	1802	3	1	2(5/8)(8)	1	State: Minnesota	Range: 31W
	PON 1: 1C/17					60(1)(1.25)	80		County: Morrison	
	PON 1: 1C/17					60(2)(1.25)	50		Range: 31W	
									Twp: 130N Section: 5	
									Township: PARKER	
									Staked By: JMM Date: 2-5-15	
									Revised By: _____ Date: _____	
									Revised By: _____ Date: _____	
									Revised By: _____ Date: _____	
									As-Built By: MN Date: 5-9-17	
									Sheet No. 11 of 27	

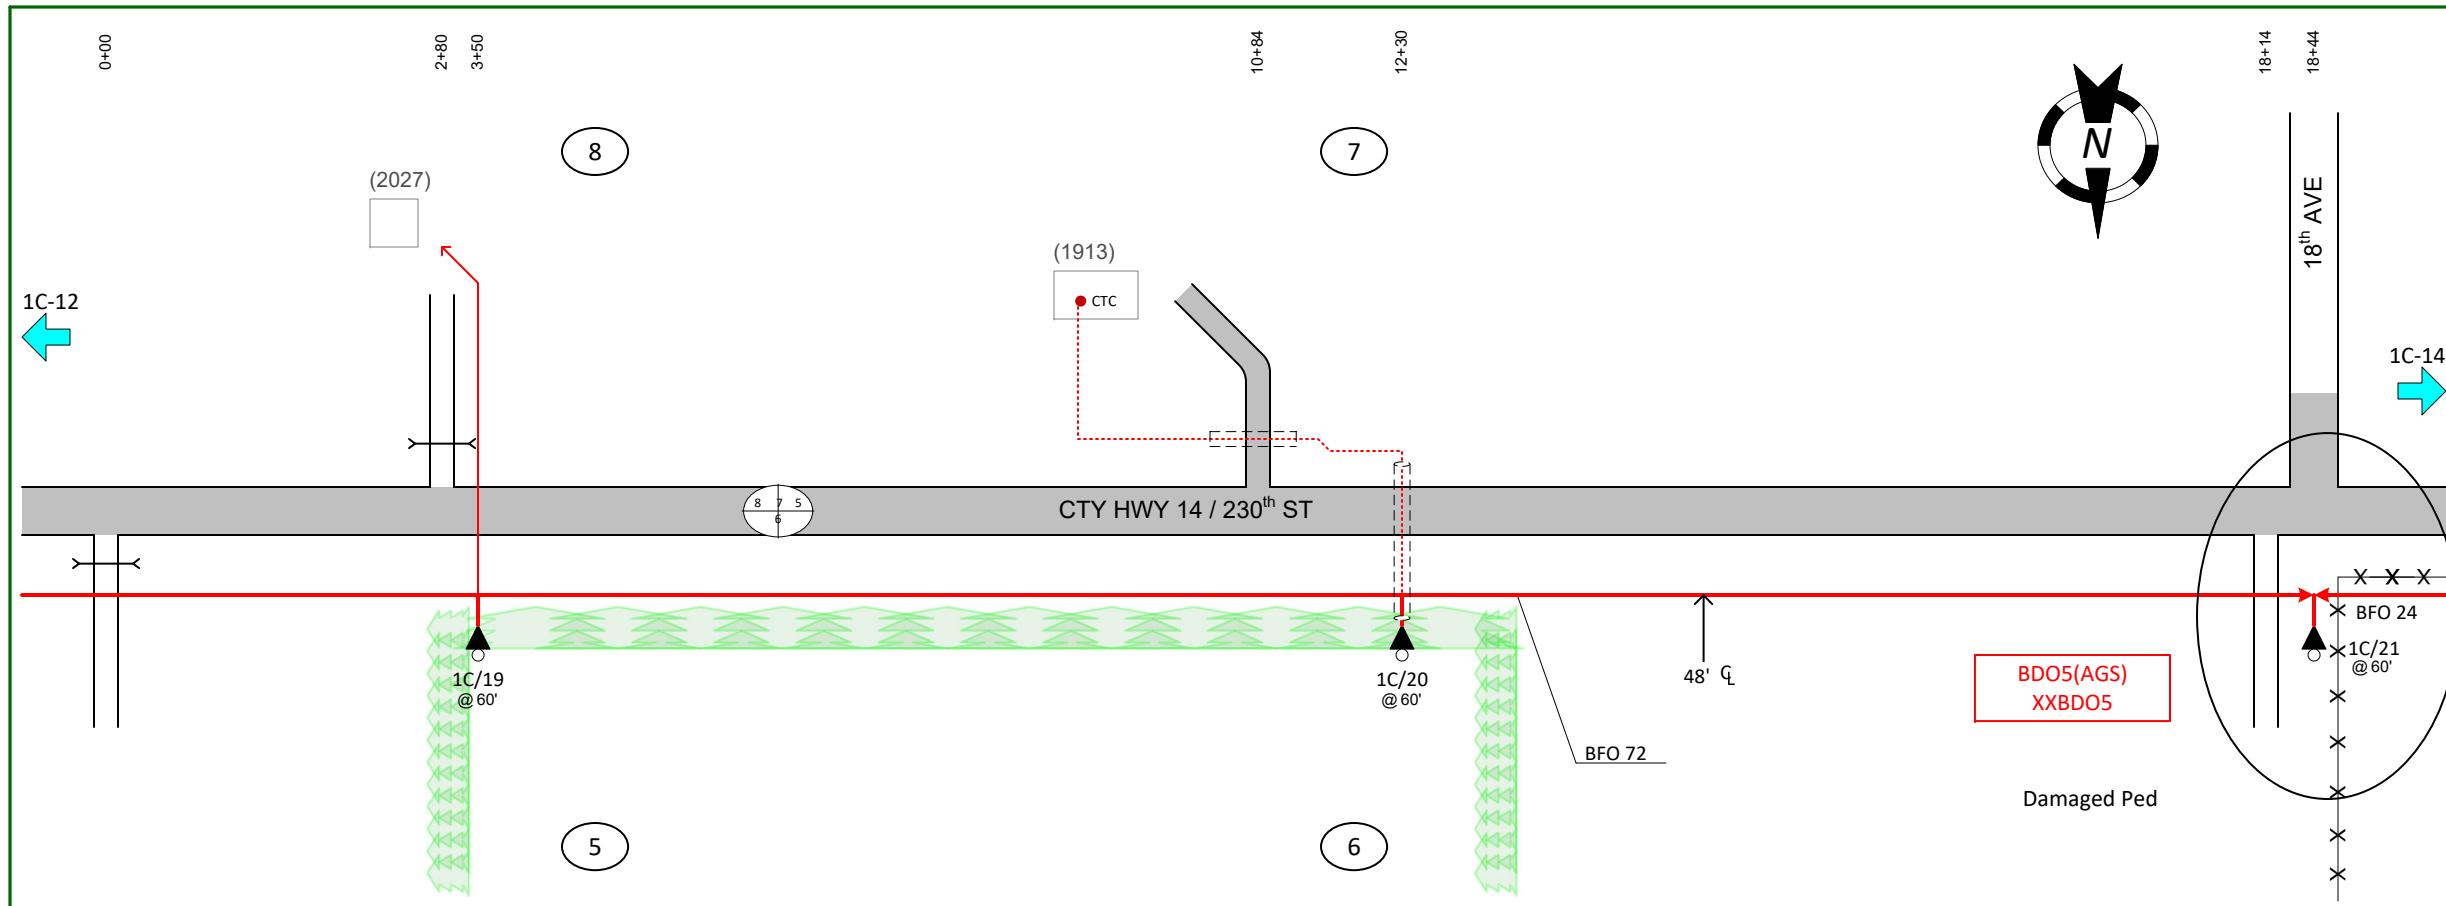

From	To	PType	Units	Feet	BA	BM	HO	Remarks	CTC	As Built
(PON 1: 1C/18)	PON 1: 1C/19	BDO5(AGS)	BFO 72	1276	3	1	2(5/8)(8)	1		Consolidated Telephone Company
	PON 1: 1C/19						53A	1		Name: 1C-13
PON 1: 1C/19	PON 1: 1C/20	BDO5(AGS)	BFO 72	970	3	1	2(5/8)(8)	1		WO: 2016 CTC
	PON 1: 1C/20						53A	1		Exch: Randall
PON 1: 1C/20	PON 1: 1C/21	BDO5(AGS)	BFO 72	652	3	1	2(5/8)(8)	1		Route: 1C
	PON 1: 1C/21						53A	1		ROW: Public
										State: Minnesota
										County: Morrison
										Range: 31W
										Twp: 130N Section: 5
										Township: PARKER
										Staked By: JMM Date: 2-5-15
										Revised By: _____ Date: _____
										Revised By: _____ Date: _____
										Revised By: _____ Date: _____
										As-Built By: MN Date: 5-9-17
										Sheet No. 13 of 27