


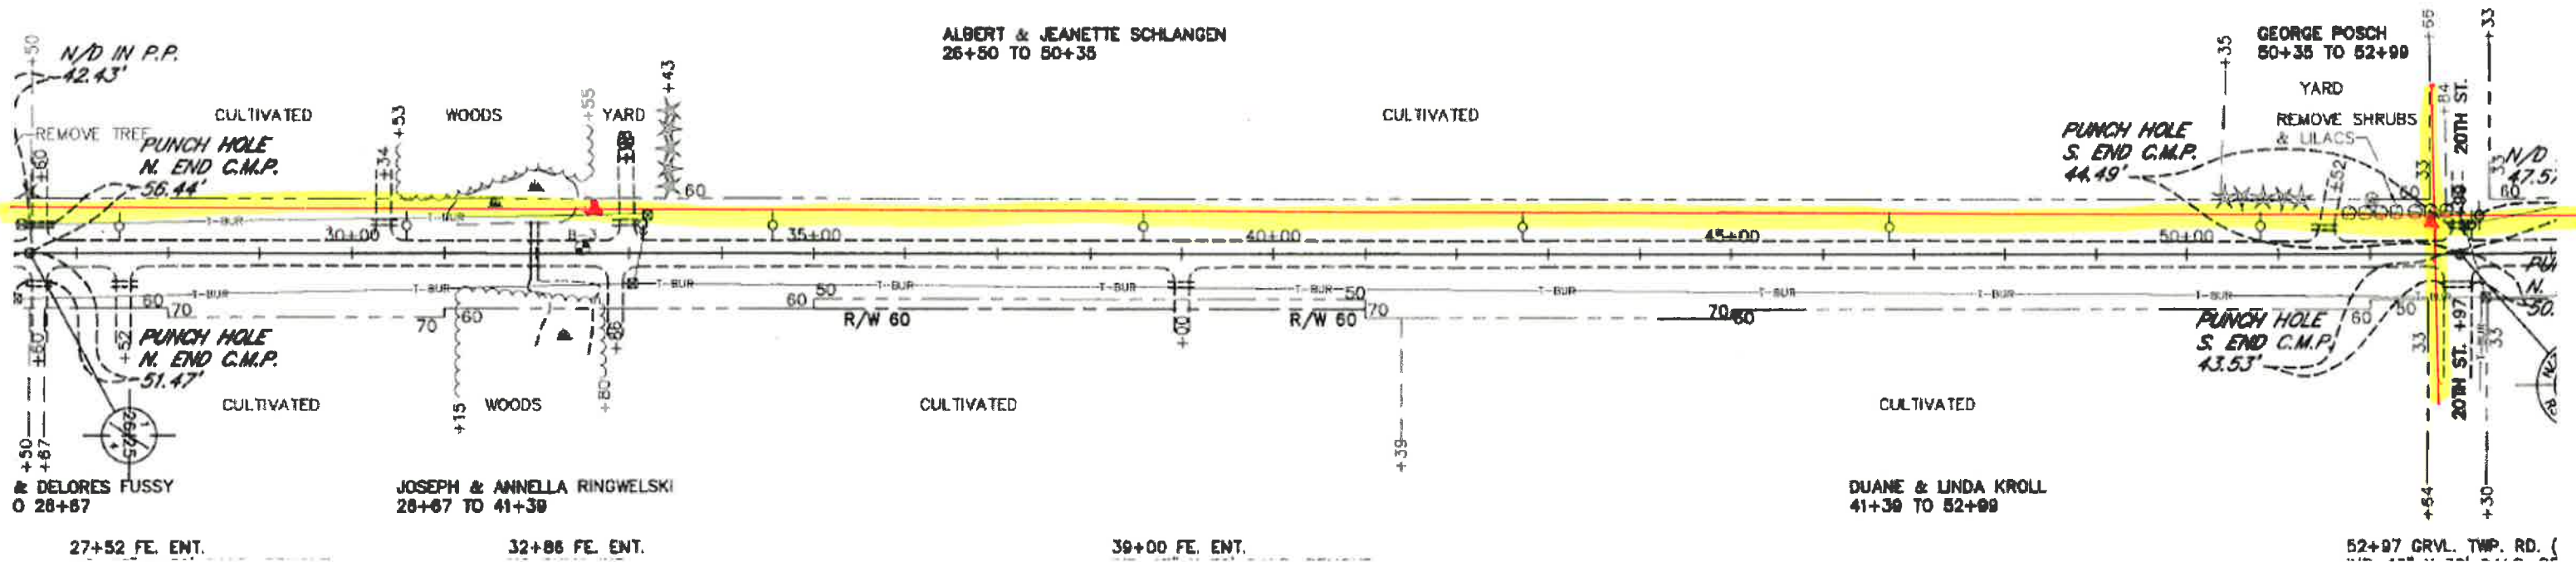

N →

2-G.S. PIPE APRONS (STD.)

BITUMEN FC CIVIL
15" X 34' C.S. PIPE CULV.
2 G.S. PIPE APRONS (STD.)

PATRICK & RITA BIENIEK
52+00 TO 57+00

SOPHIA BIENIEK
57+00 TO 61+28

61+61 - 63+10
OFFSET LEFT 50'-350'
TEMPORARY STOCKPILE AREA
FOR UNSUITABLE MATERIAL

CONRAD & EVELYN BIENIEK
61+28 TO 79+45

CULTIVATED
CONSTRUCT BERM ALONG R/W TO PREVENT SHEET FLOW INTO FIELD
PAYMENT SHALL BE INCIDENTAL TO COMMON EXCAVATION

DAVID & TAMARA SCHLUMPBERGER
67+70 TO 79+29


72+55 FE. ENT. MOVE TO 72+00
INP. 15" X 30' C.M.P. REMOVE
15" X 38' C.S. PIPE CULV.
2-G.S. PIPE APRONS (STD.)
CONSTRUCT AS HSE. ENT.

JOSEPH KUKLOK, MARTIN KUKLOK, ROBERT SOBANIA & MELISSA KUKLOK
58+29 TO 67+70

66+20
CONSTRUCT NEW HSE. ENT.
NO ENTRANCE INPLACE
NO CULVERT REQUIRED

AS BUILT 2004

N →

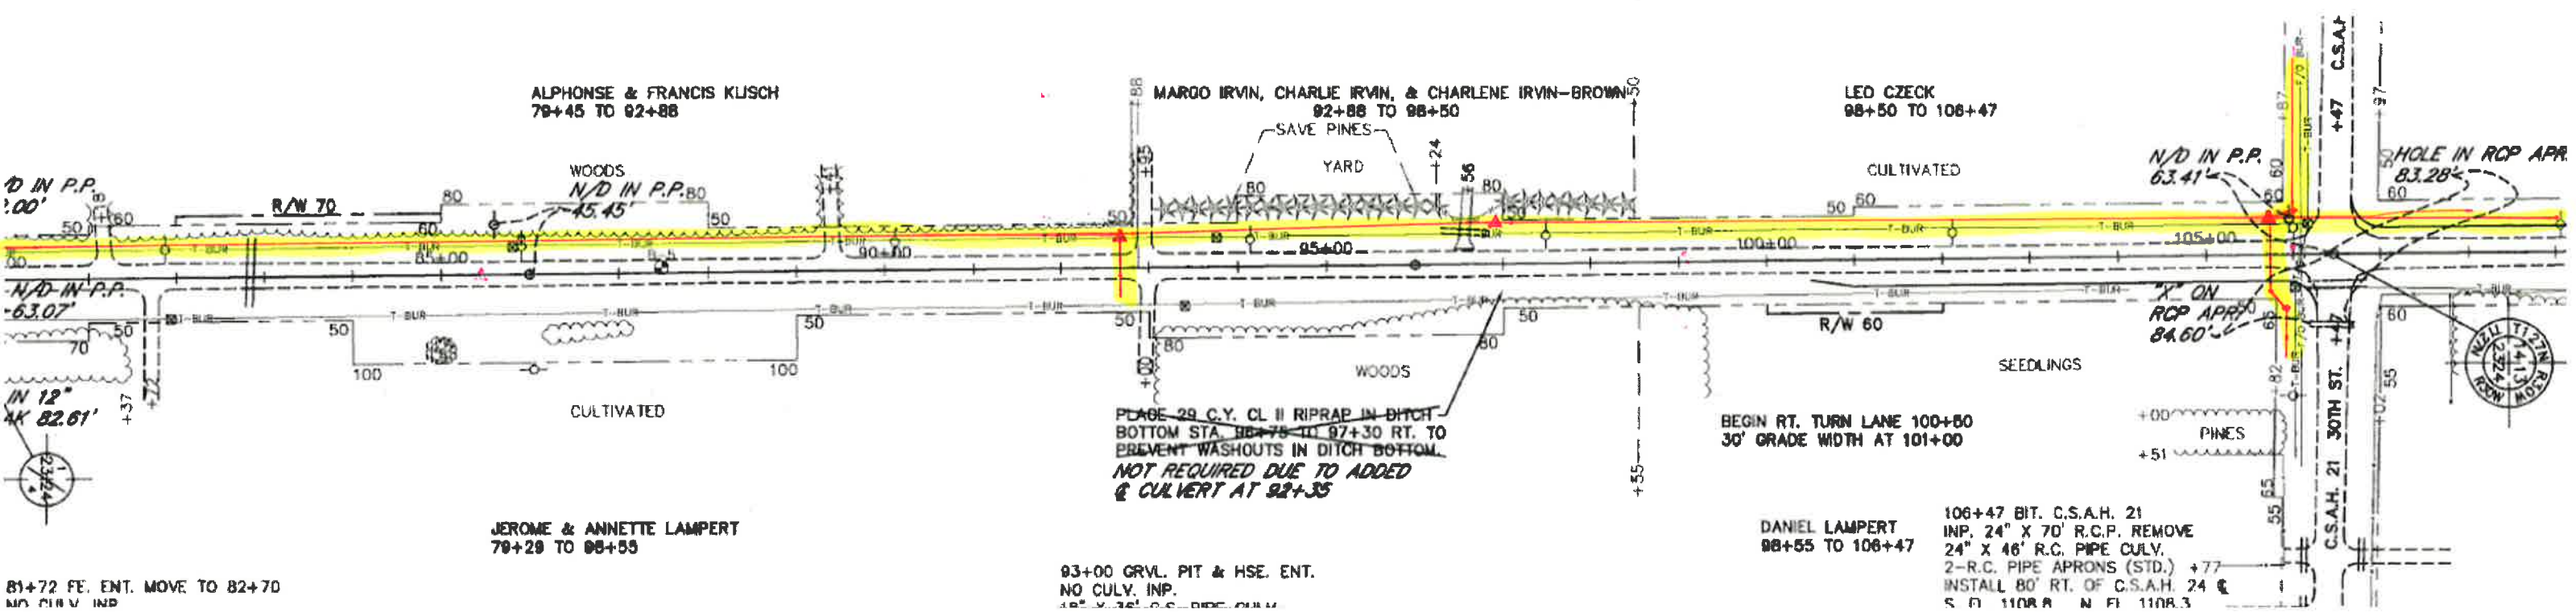

81+72 FE. ENT. MOVE TO 82+70
NO CULV. INP.


JEROME & ANNETTE LAMPERT
79+29 TO 98+55

93+00 GRVL. PIT & HSE. ENT.
NO CULV. INP.


DANIEL LAMPERT
98+55 TO 106+47

106+47 BIT. C.S.A.H. 21
INP. 24" X 70' R.C.P. REMOVE
24" X 46' R.C. PIPE CULV.
2-R.C. PIPE APRONS (STD.) +77
INSTALL 80' RT. OF C.S.A.H. 24 &
S.D. 110R.8 N.E. 110R.3

N →

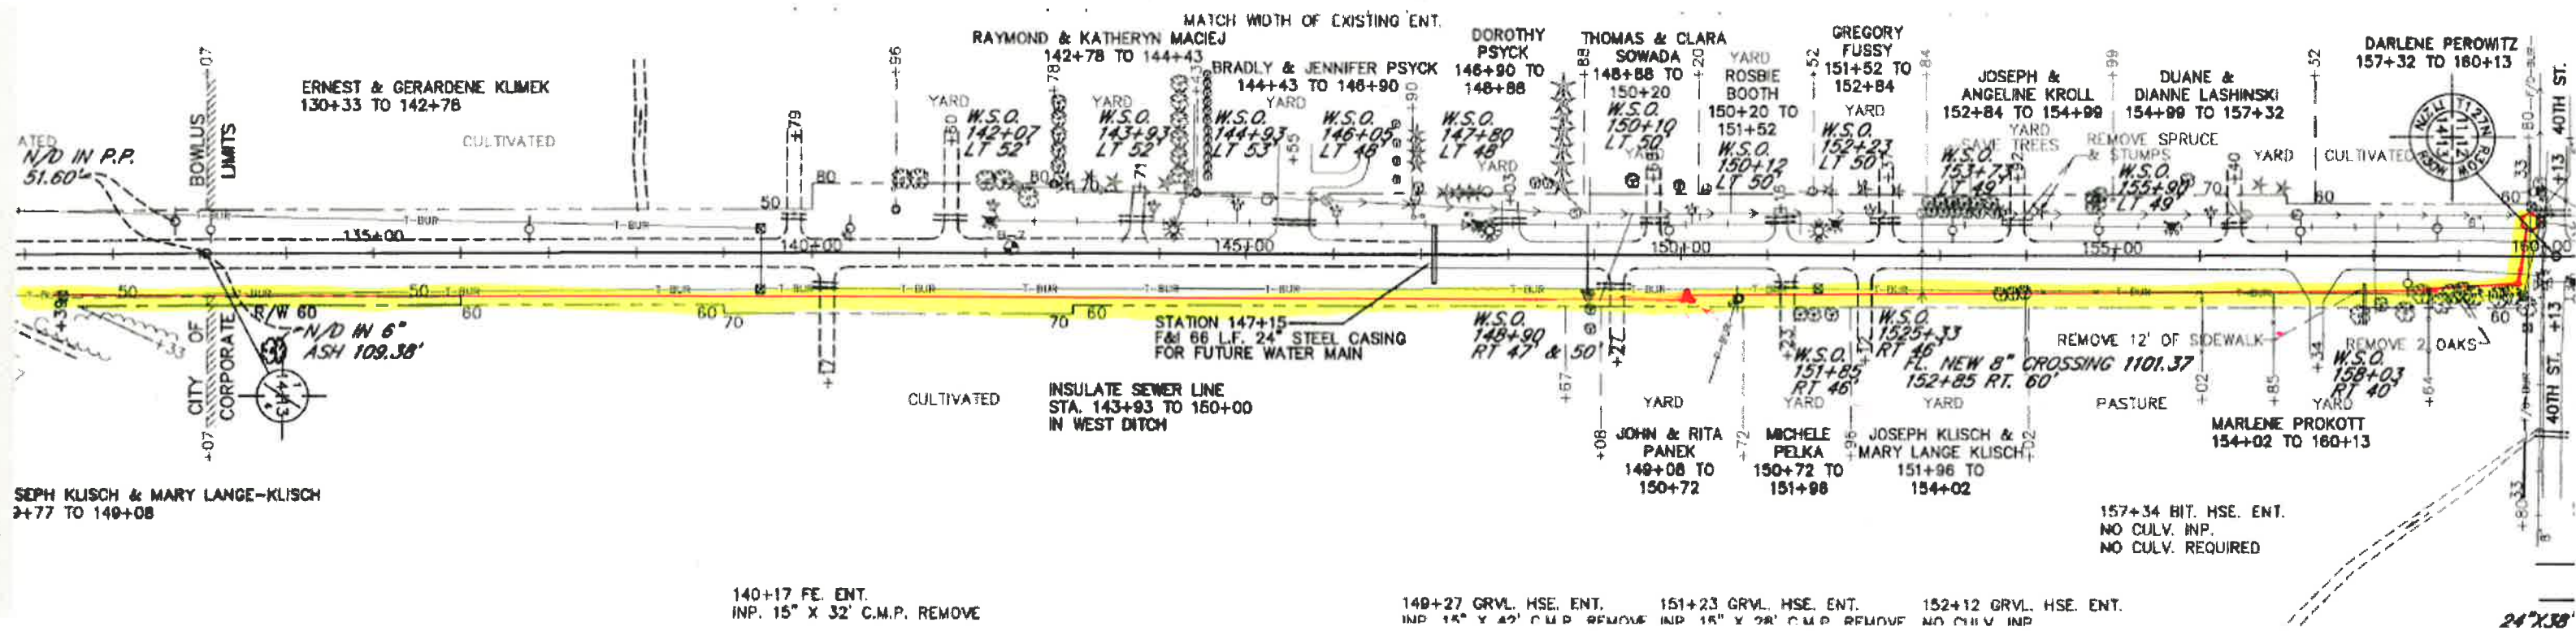

N →

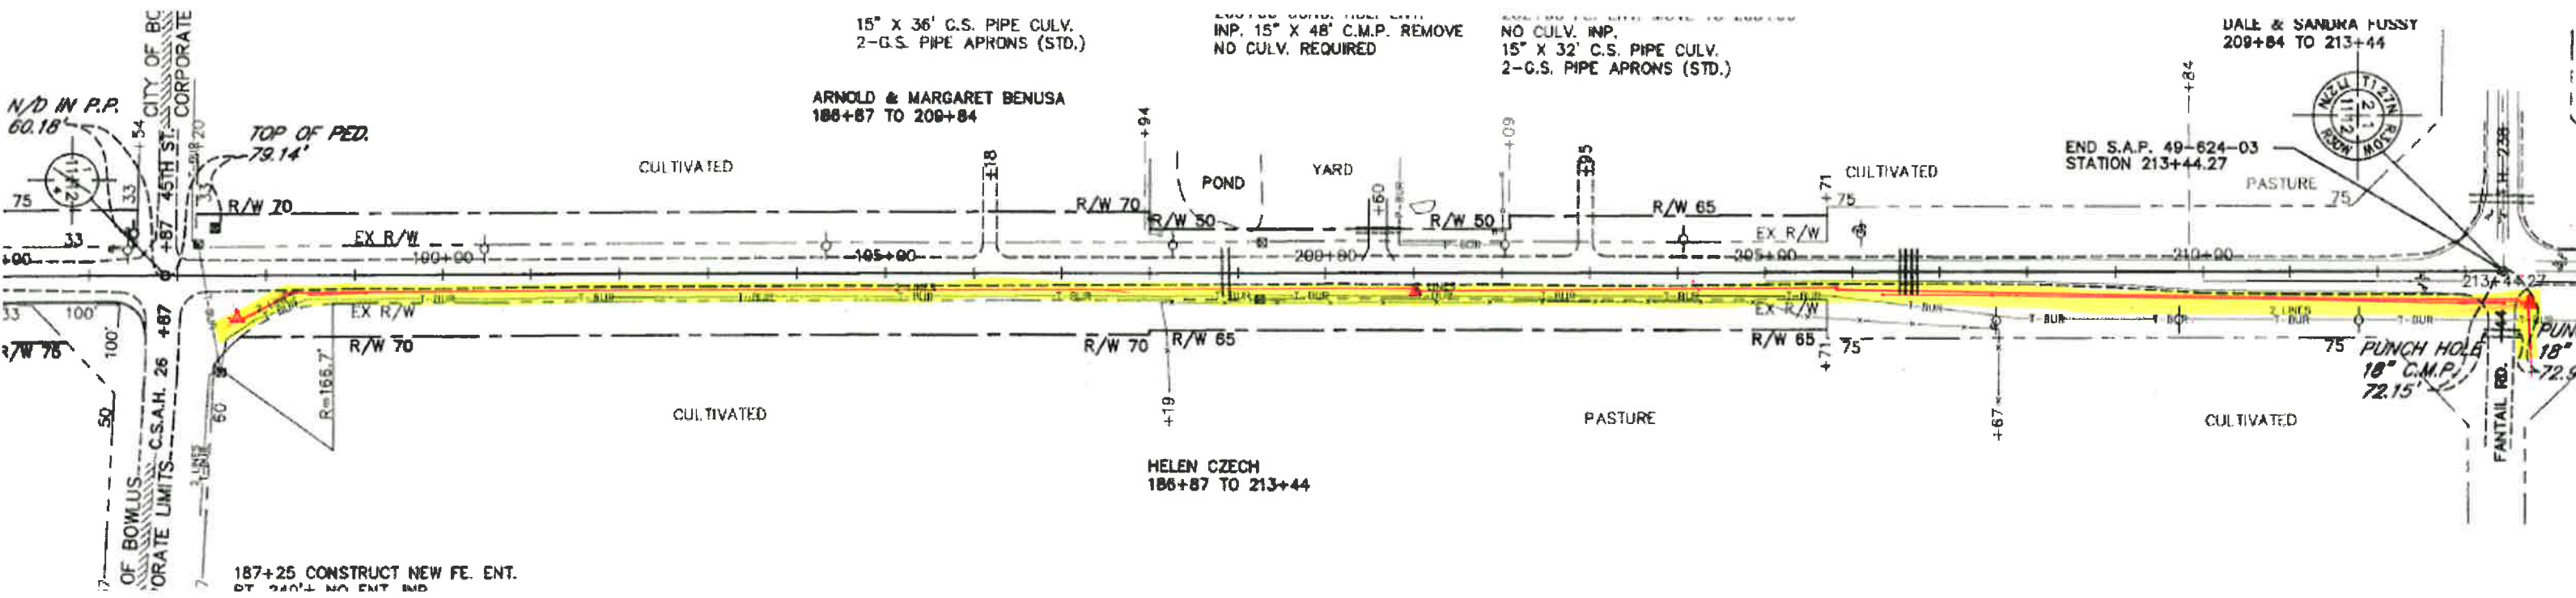

N →