




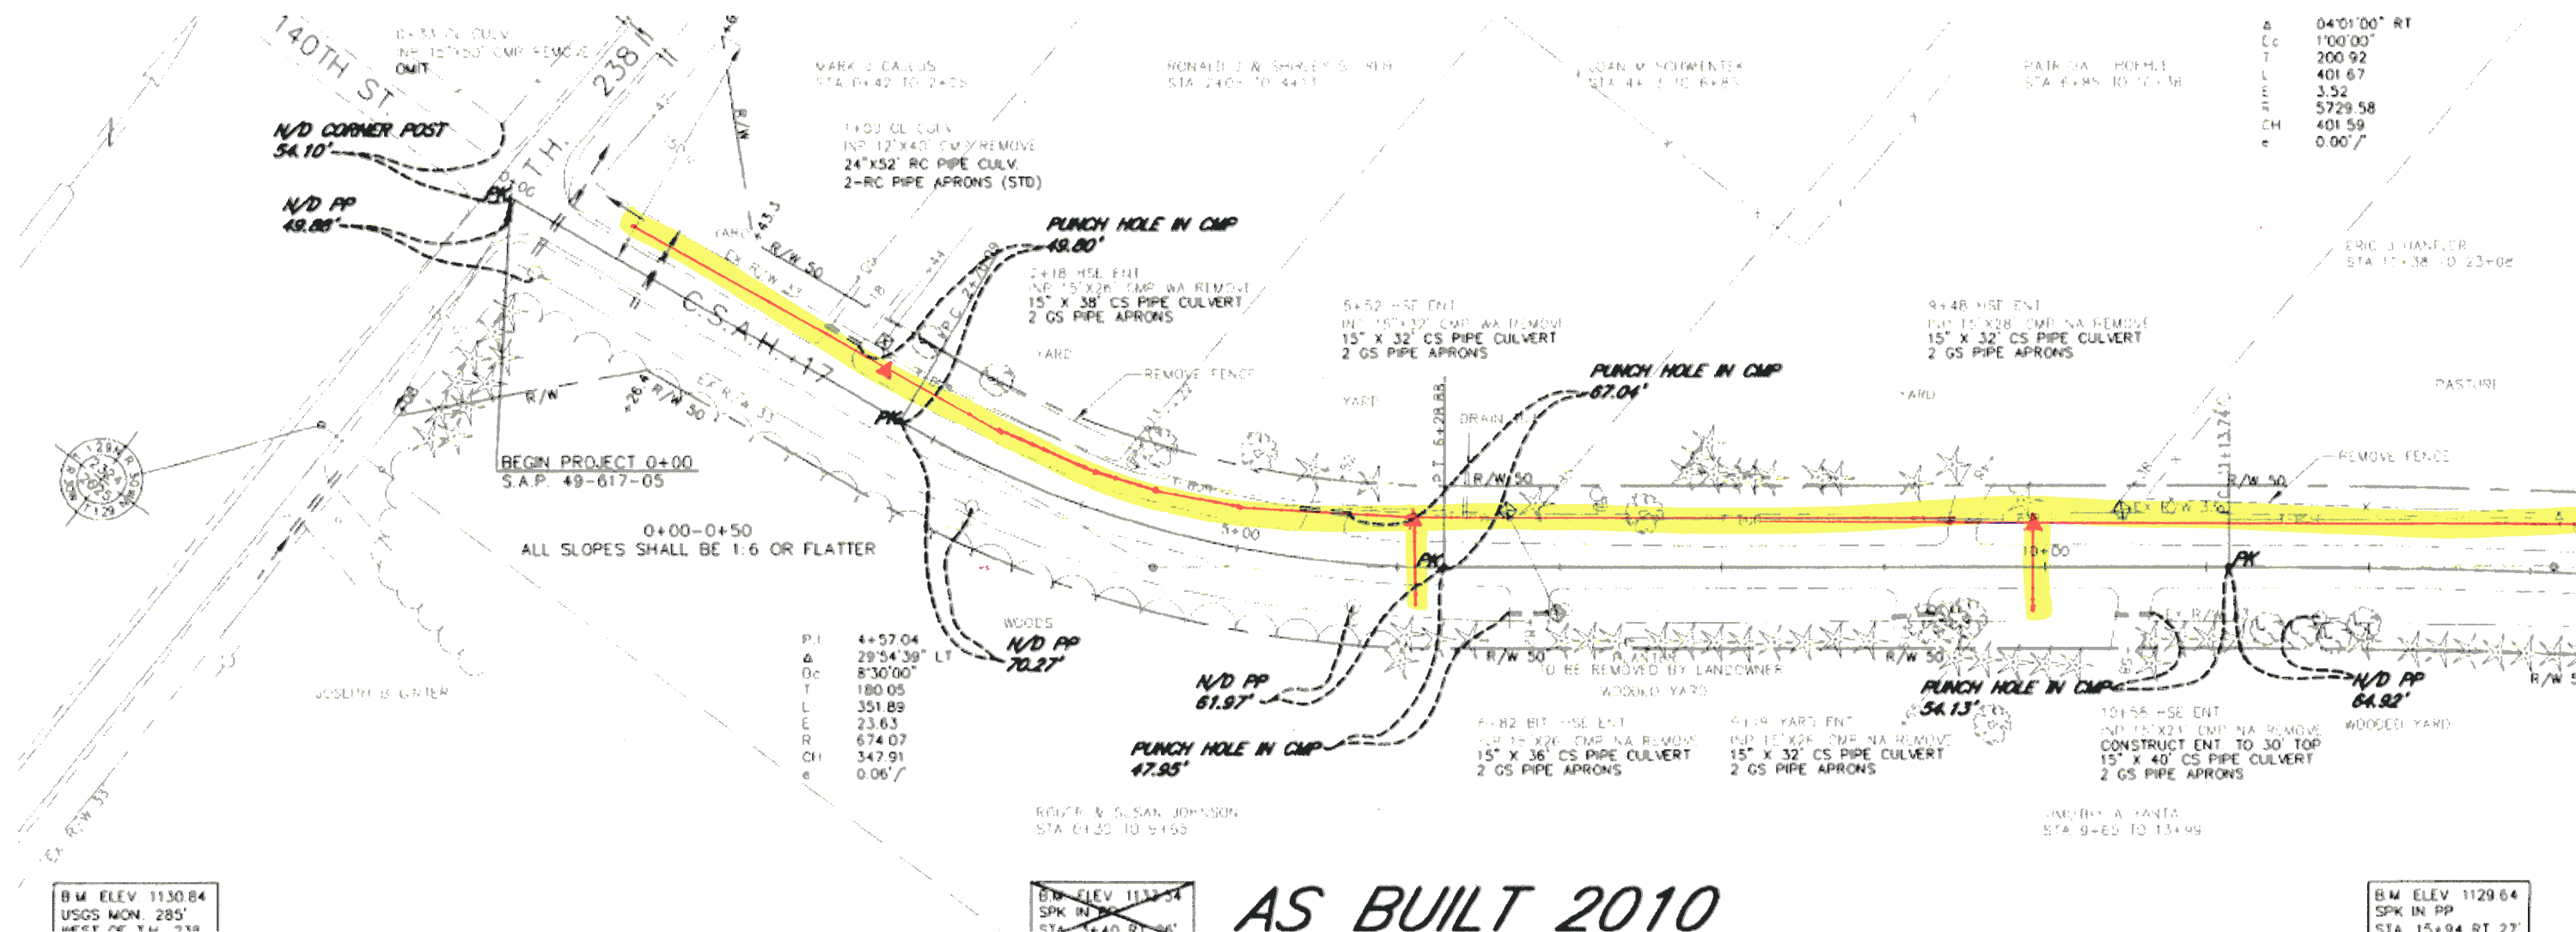

AS BUILT 2010

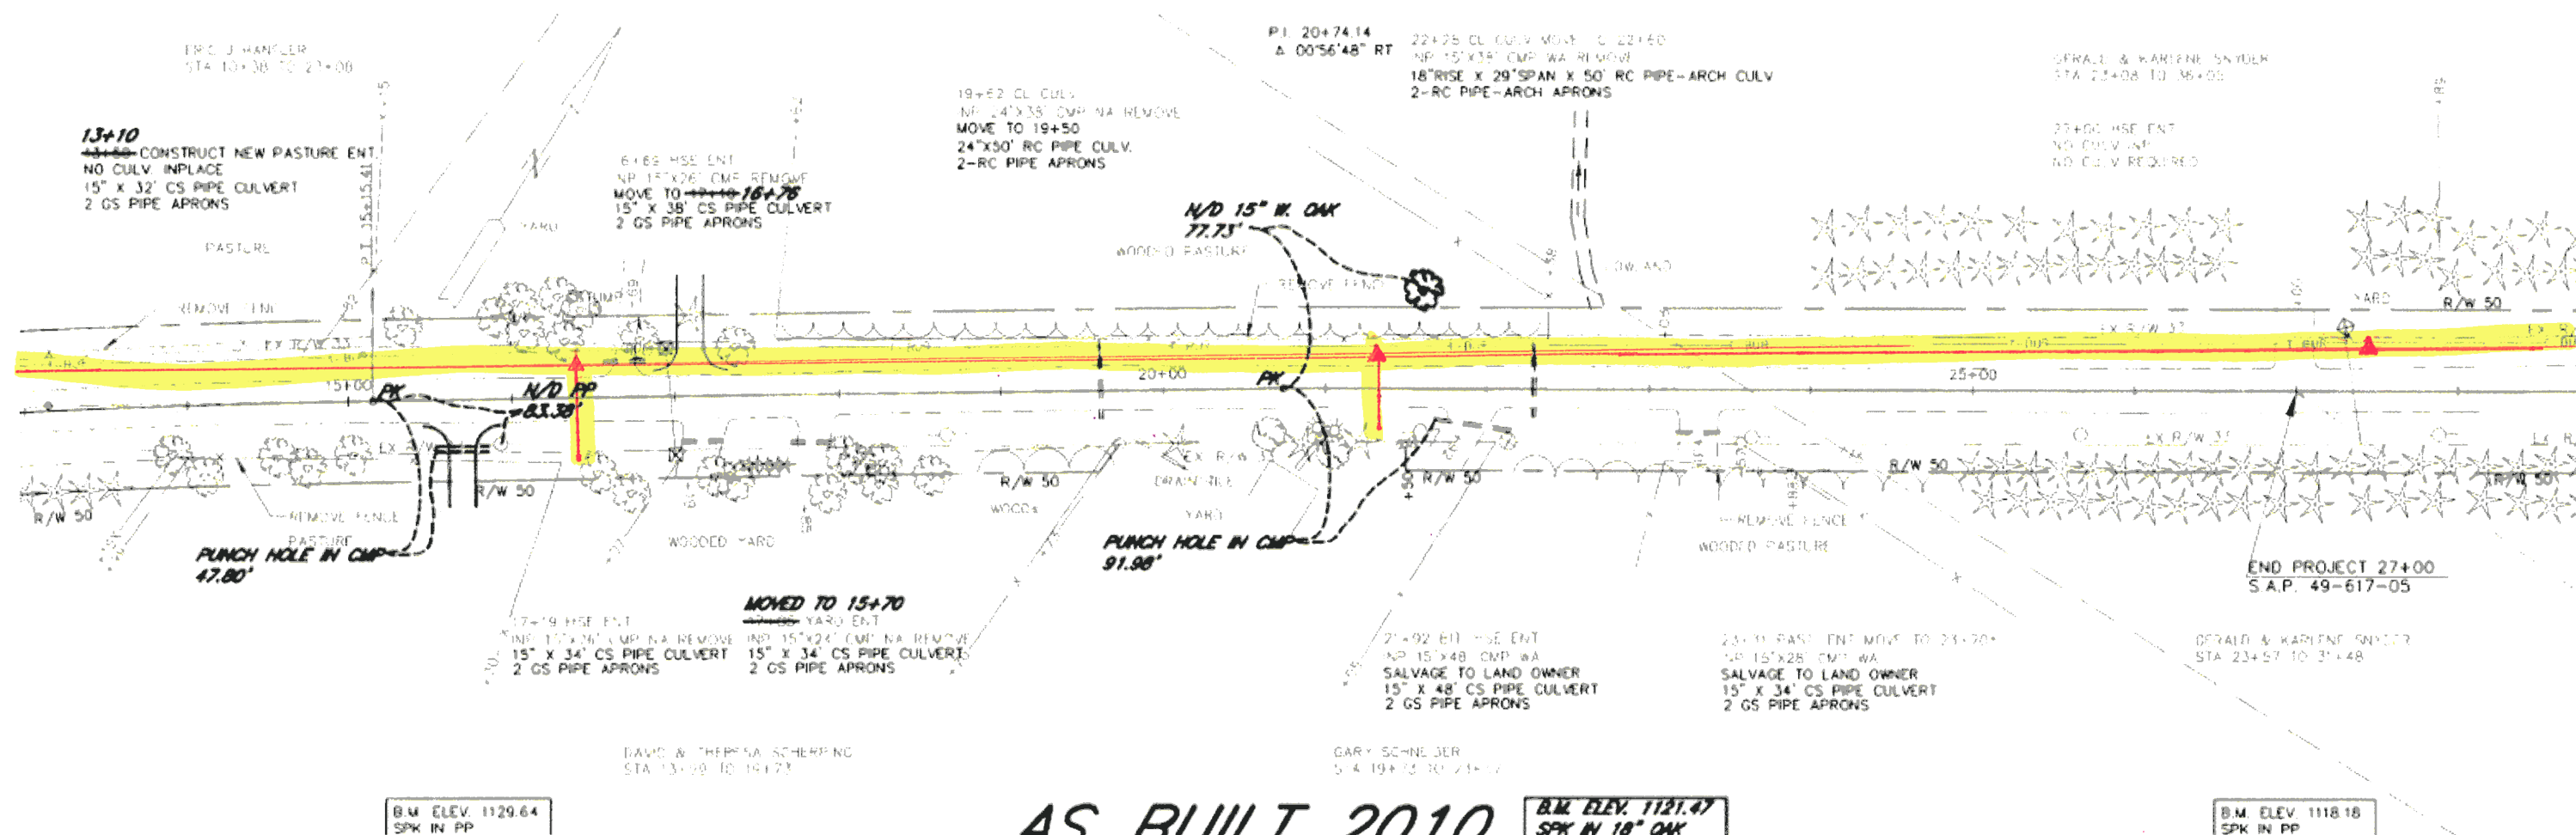

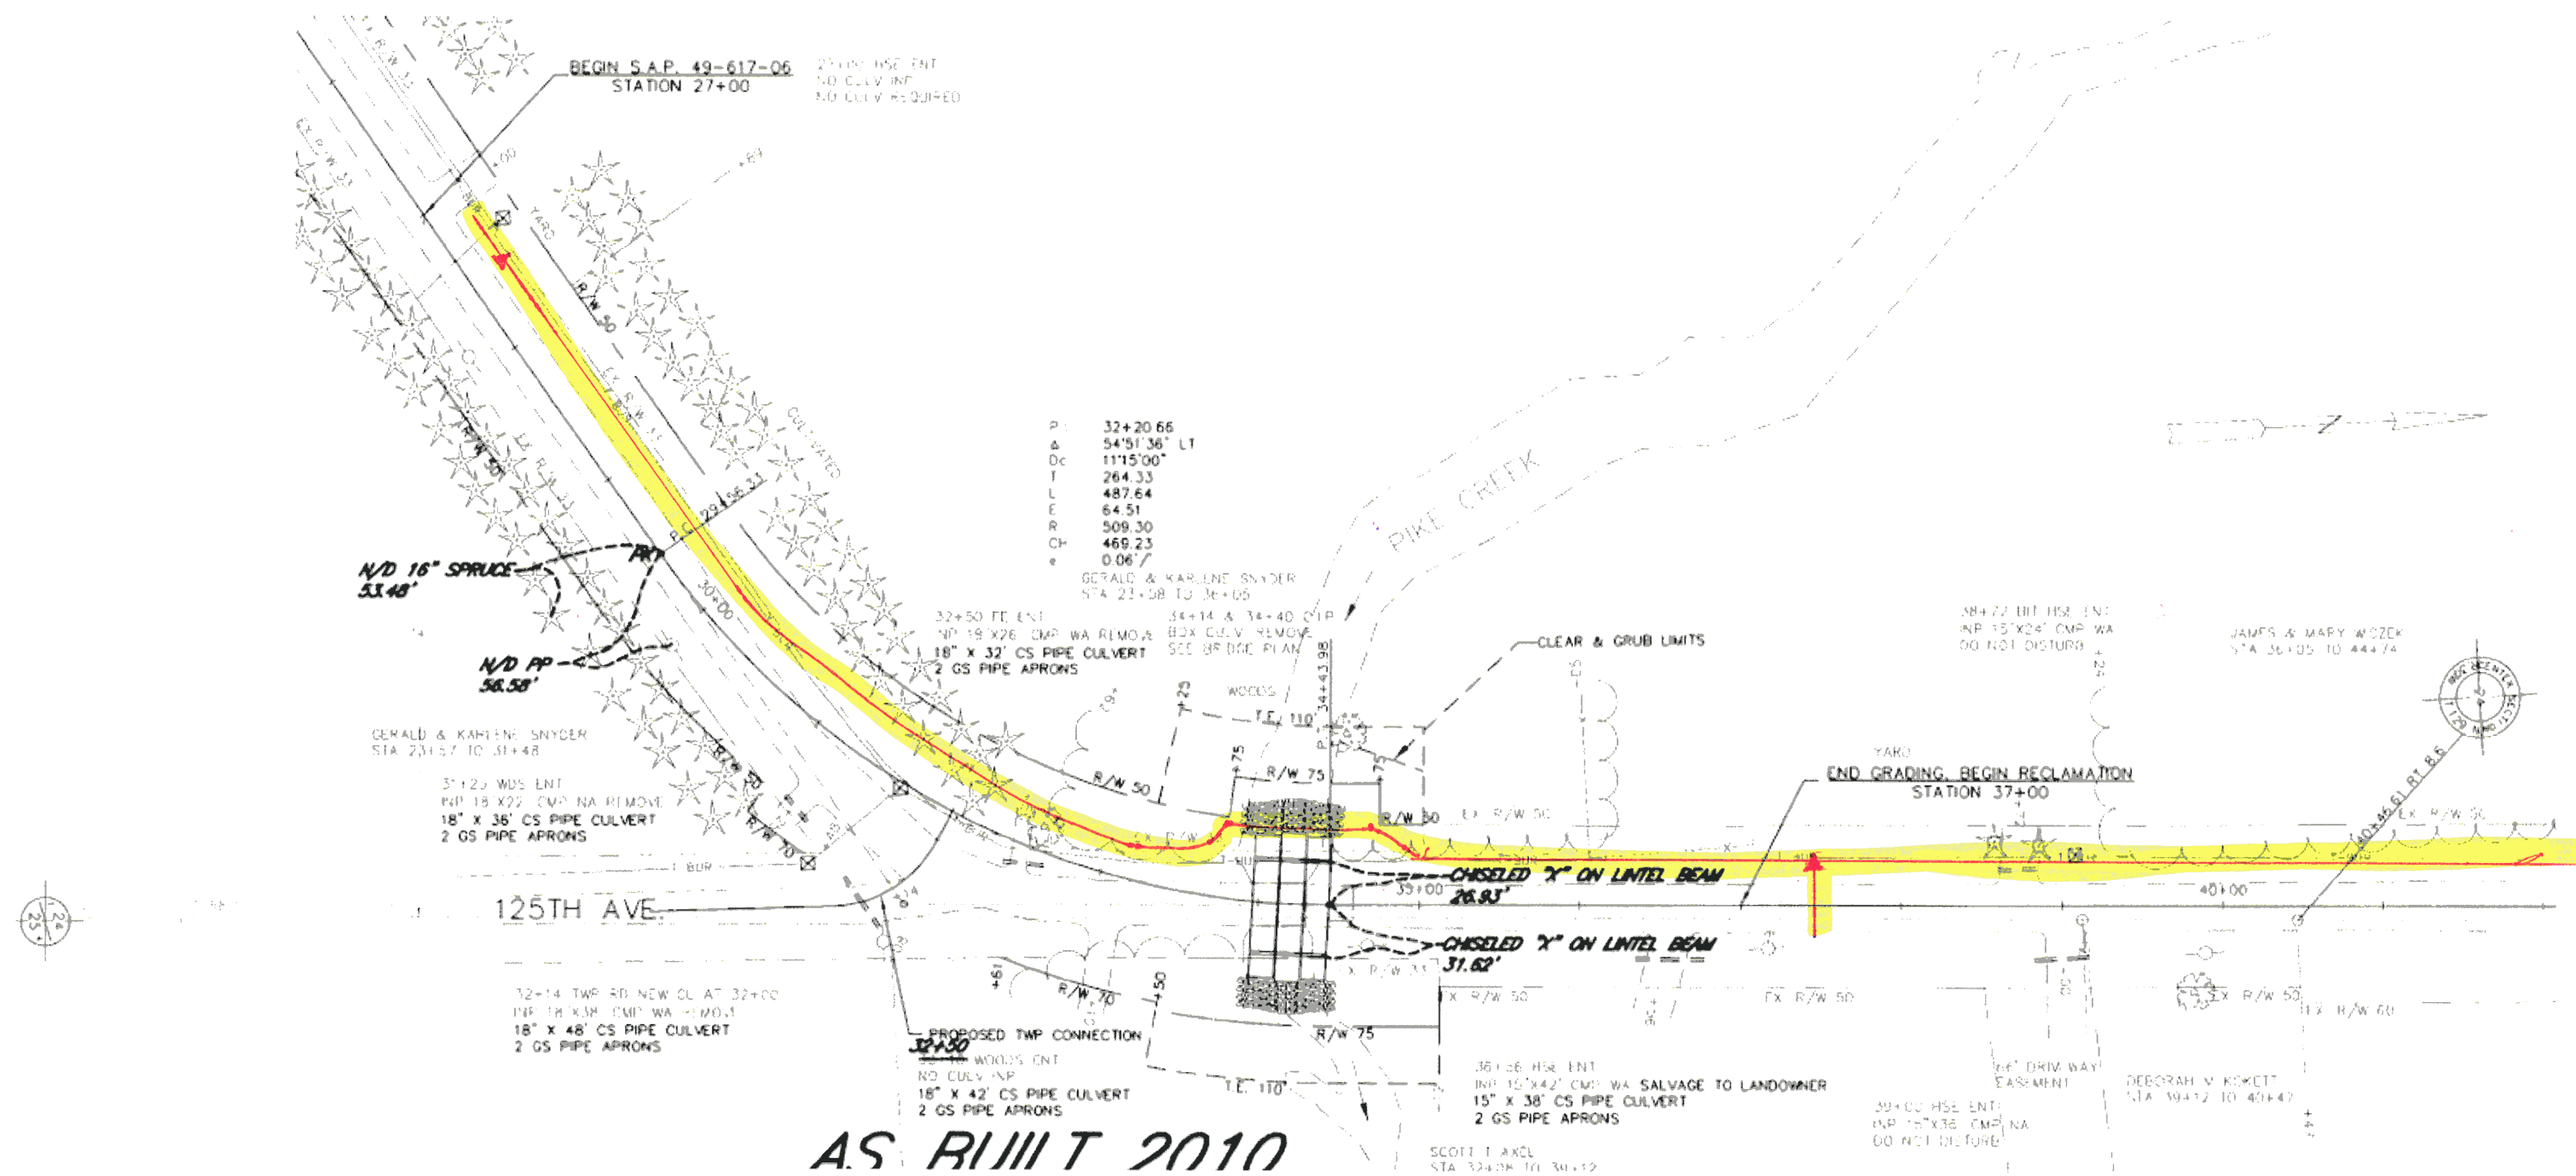

44+28-48+92 WIDENED ABOUT EXISTING CL

46+54 HSE ENT
NO CULV INF

STOTT & STAMM NOHS
STA 45+09-48+45

MANDIE JOHANSEN
STA 49+45 TO 52+77

GEORGE MARSDEN
STA 52+77 TO 59+42

PJ 47+18.41
Δ 87°06'49" RT
Dc 18'47'08"
I 290.01
L 463.73
E 115.87
R 305
CH 420.33
e 0.067

49+12 CL CULV
INP 18"X54" CMP NA REMOVE 0' FROM EACH END
EXTEND 8' LT & 6' RT
2 GS PIPE APRONS

47+90 HSE ENT
INP 15"X36" CMP WA REMOVE
15"X48" CS PIPE CULVERT
2 GS APRONS

51+15 HSE ENT
INP 15"X36" CMP WA REMOVE
15"X48" CS PIPE CULVERT
2 GS PIPE APRONS

52+75 FWP RD
INP 15"X48" CMP NA
DO NOT DISTURB

52+15 FWP RD
INP 15"X36" CMP NA
DO NOT DISTURB

MARIN S. DOLGOMIR
STA 49+45 TO 56+09

RICHARD W. & ALVINA RICHEN
STA 56+09 TO 59+42


45+00-49+00 RT. CLEARED & GRUBBED
WITHIN EXISTING R/W

DANA J. CLEN
STA 47+47 TO 49+45

47+65 HSE ENT
INP 15"X36" CMP NA
DO NOT DISTURB

37+00-66+50 RECLAIMED & WIDENED
NO PROFILE REVISIONS WERE MADE

AS BUILT 2010

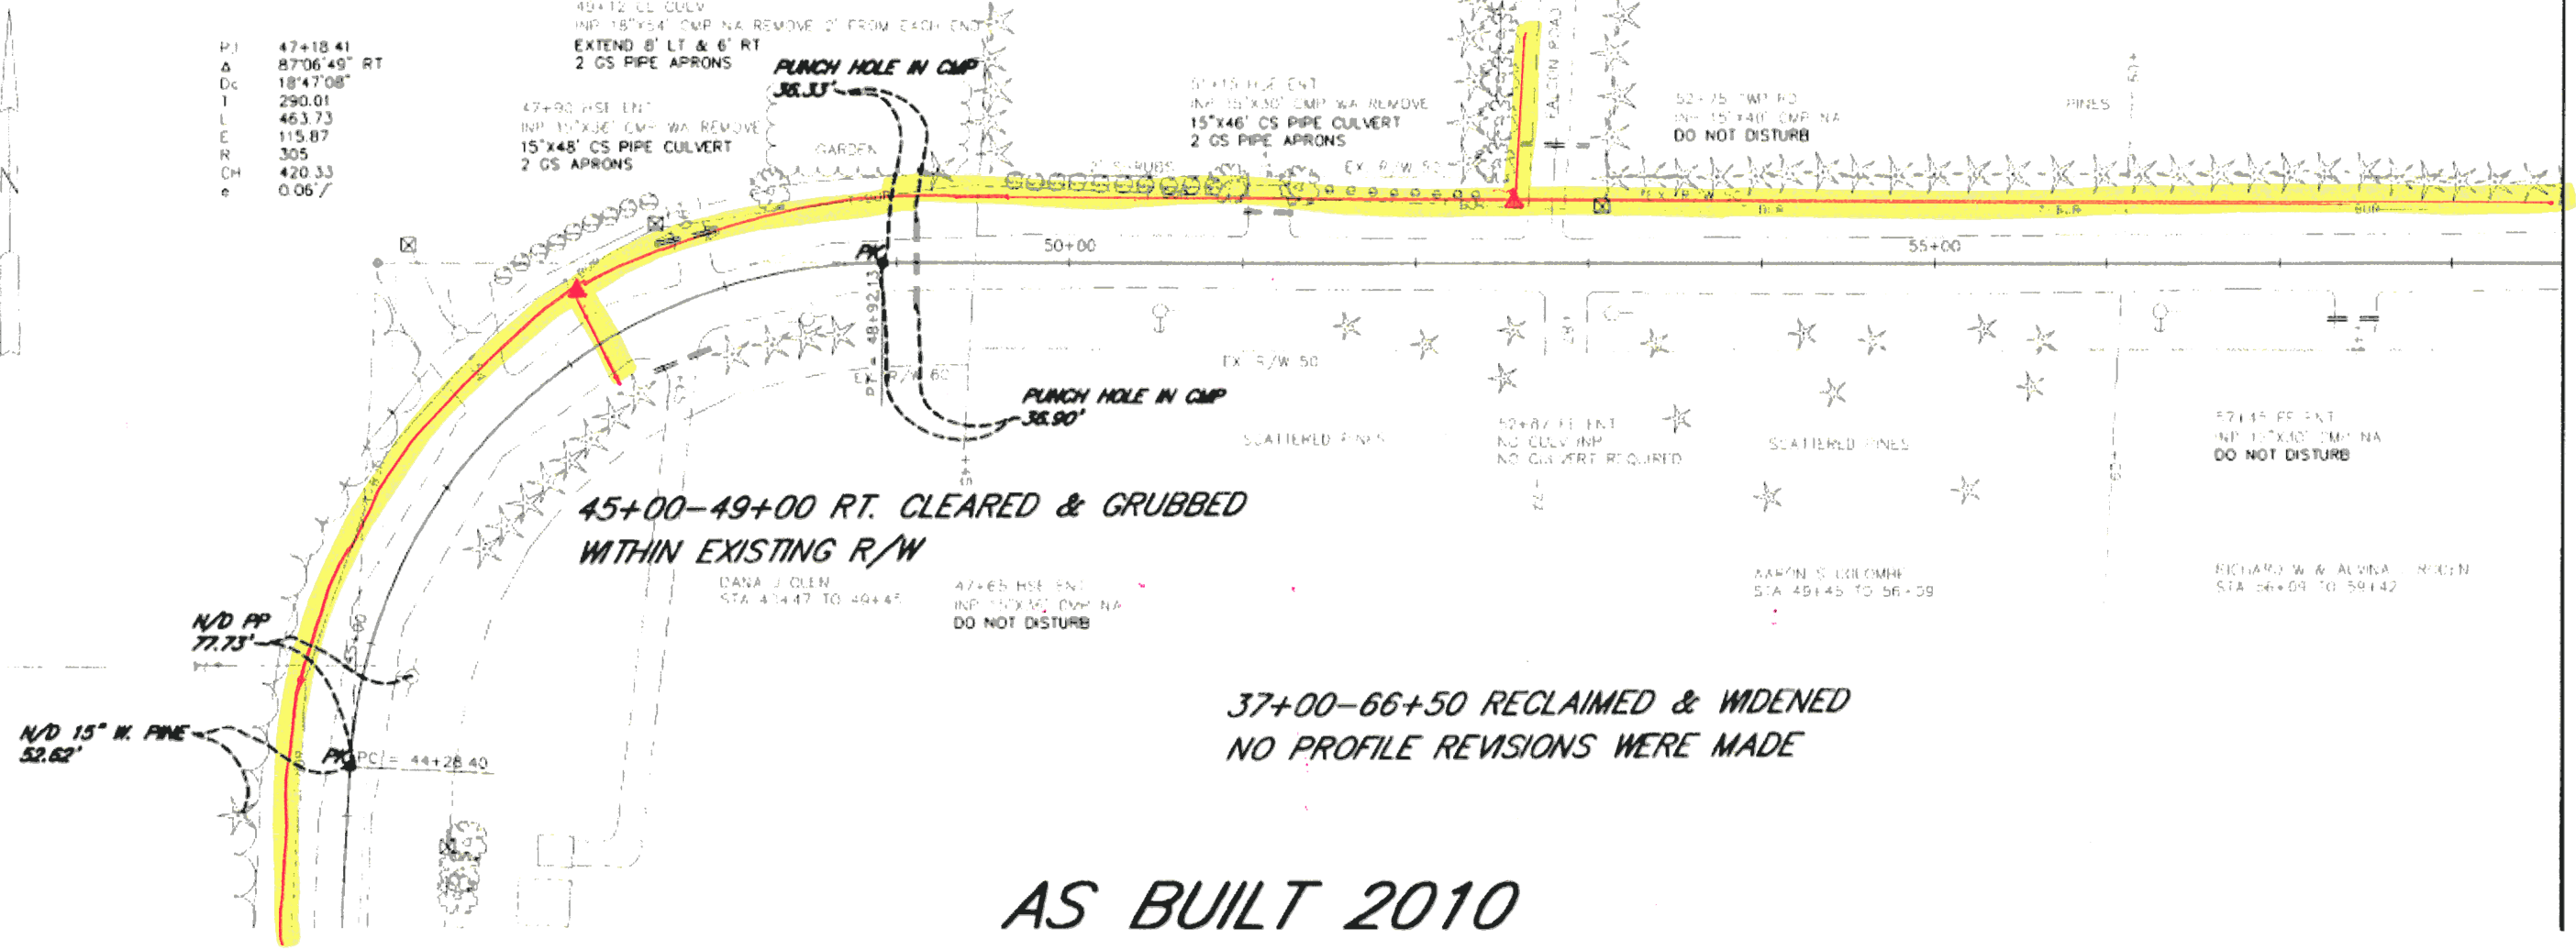

P.O.T. 66+16.29

MARGARET BLANKS
STA 59+42 TO 62+74

ALAN F. KUDOWSKI
STA 62+74 TO 65+86

RAYMOND JOHN VAN COCK JR.
STA 65+16 TO 69+38

59+61 HSE ENT
15'X34' CMP NA
DO NOT DISTURB

N/D PP
66.80'

65+17 TW 60
15'X30' CMP NA
DO NOT DISTURB

69+44 CL CULV
15'X30' CMP NA

60+00

65+00

N/D PP
92.25'

62+73 HSE ENT
15'X28' CMP NA
DO NOT DISTURB

66+16 FC ENT
15'X32' CMP NA
DO NOT DISTURB

END PROJECT 66+50
S.A.P. 49-617-06

L. RODEN

KAY M. BINKLEY
STA 59+42 TO 62+74

RICHARD W. & ALVINA L. RODEN
STA 62+74 TO 66+06

RICHARD W. & ALVINA L. RODEN
STA 66+06 TO 69+38

**37+00-66+50 RECLAIMED & WIDENED
NO PROFILE REVISIONS WERE MADE**

AS BUILT 2010