



Customer Status	CustomerType	Pedestals	CO and Cabinets	Distribution Fiber Cable	Conduit	Public Waterways
● Active	□ Business	▲ Complete	⬡ Cabinet	— Buried - Existing	— Proposed	----- Public Ditch/Altered Natural Watercourse
● Inactive	⊙ Industrial	▲ Proposed	⬡ Central Office	· · · Buried - Proposed	— Existing	----- Public Water Watercourse
● Potential	⊙ Multi-Unit	<b>Handhole</b>		<b>Network Fiber Cable</b>		— Public Lakes
● Ready for Cutover	○ Residential	■ Proposed		— Buried - Existing		— Private Easement Area
● Requested		■ Existing	<b>Service Drop Cable</b>	· · · Buried - Proposed		— Telco Service Area
			--- Buried - Proposed			
			— Buried - Existing			




**Project:** CR 225 Pg 1 of 4

Staked By: \_\_\_\_\_ Date: \_\_\_\_\_  
 Revised By: \_\_\_\_\_ Date: \_\_\_\_\_  
 As Built By: \_\_\_\_\_ Date: \_\_\_\_\_

**CNS** Cooperative Network Services, LLC  
 14 Main St SW - Menahga, MN 56464  
 218-564-3000

ROW Width: Varies 260 ft Prepared By: \_\_\_\_\_  
 ArcGIS Online 1/5/2026

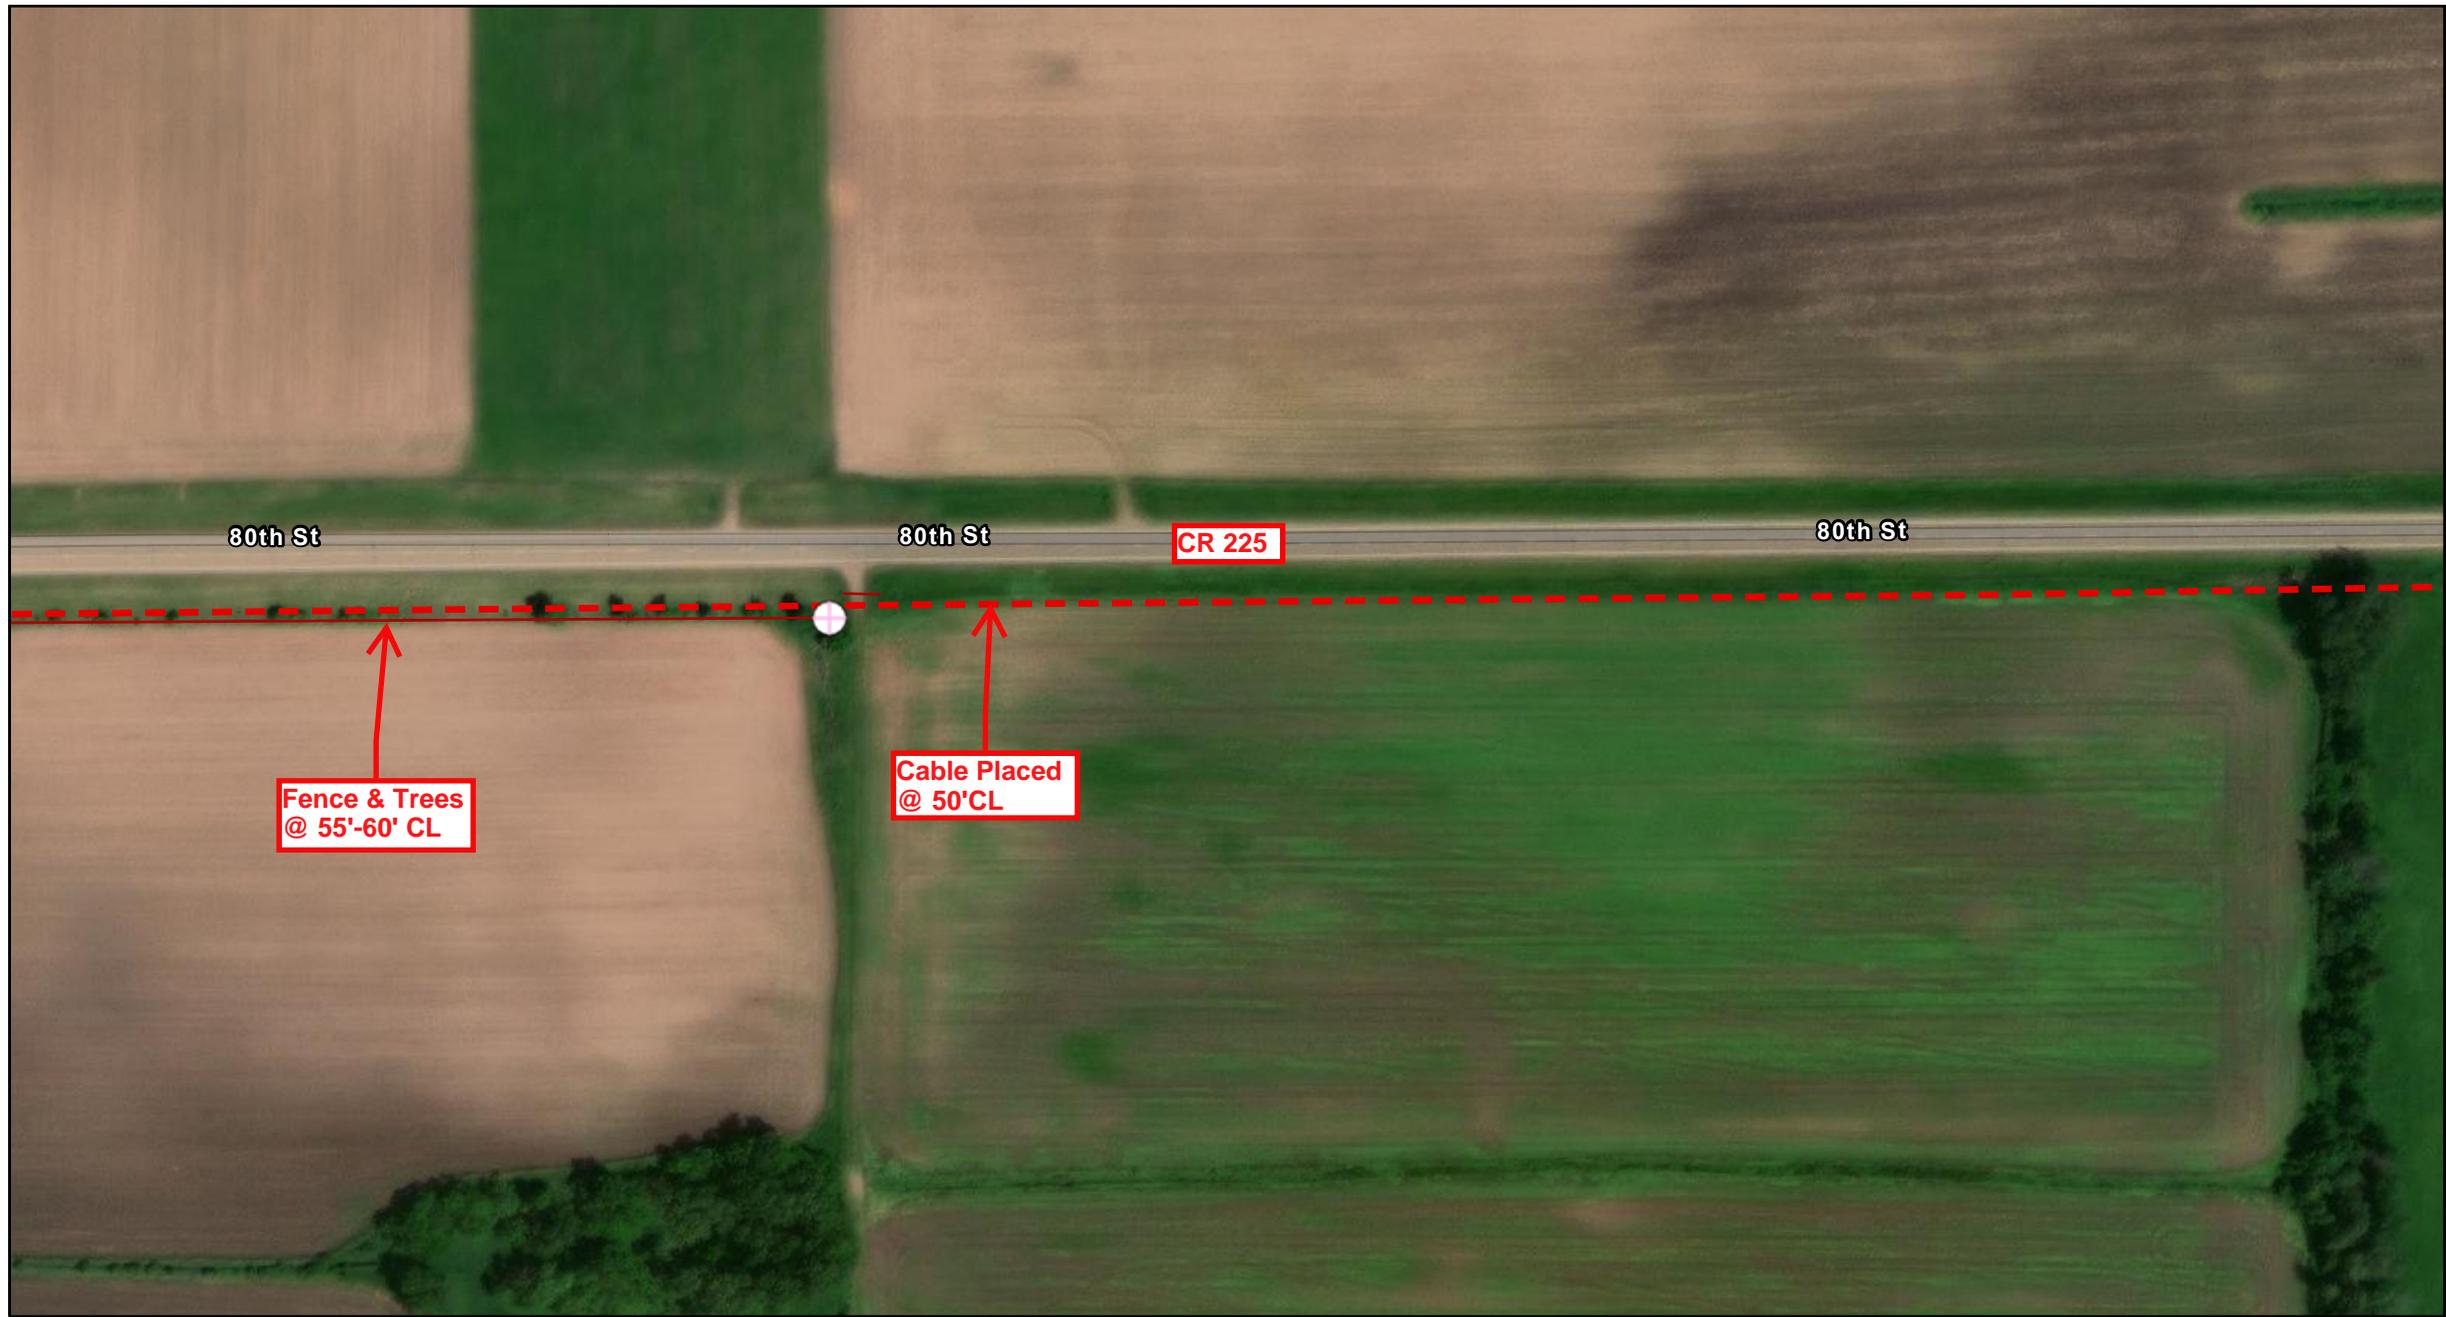


Customer Status	CustomerType	Pedestals	CO and Cabinets	Distribution Fiber Cable	Conduit	Public Waterways
● Active	□ Business	▲ Complete	⬡ Cabinet	— Buried - Existing	— Proposed	--- Public Ditch/Altered Natural Watercourse
● Inactive	⊙ Industrial	▲ Proposed	⬡ CO	· · · Buried - Proposed	— Existing	--- Public Water Watercourse
● Potential	⊙ MDU Multi-Unit	<b>Handhole</b>		<b>Network Fiber Cable</b>		— Public Lakes
● Ready for Cutover	○ Residential	■ Proposed	<b>Service Drop Cable</b>	— Buried - Existing		— Private Easement Area
● Requested		■ Existing	--- Buried - Proposed	· · · Buried - Proposed		--- Telco Service Area
		— Buried - Existing				



**Project:** CR 225 Pg 2 of 4

Staked By:	Date:	 14 Main St SW - Menahga, MN 56464 218-564-3000
Revised By:	Date:	
As Built By:	Date:	

ROW Width: Varies 260 ft Prepared By: ArcGIS Online 1/5/2026

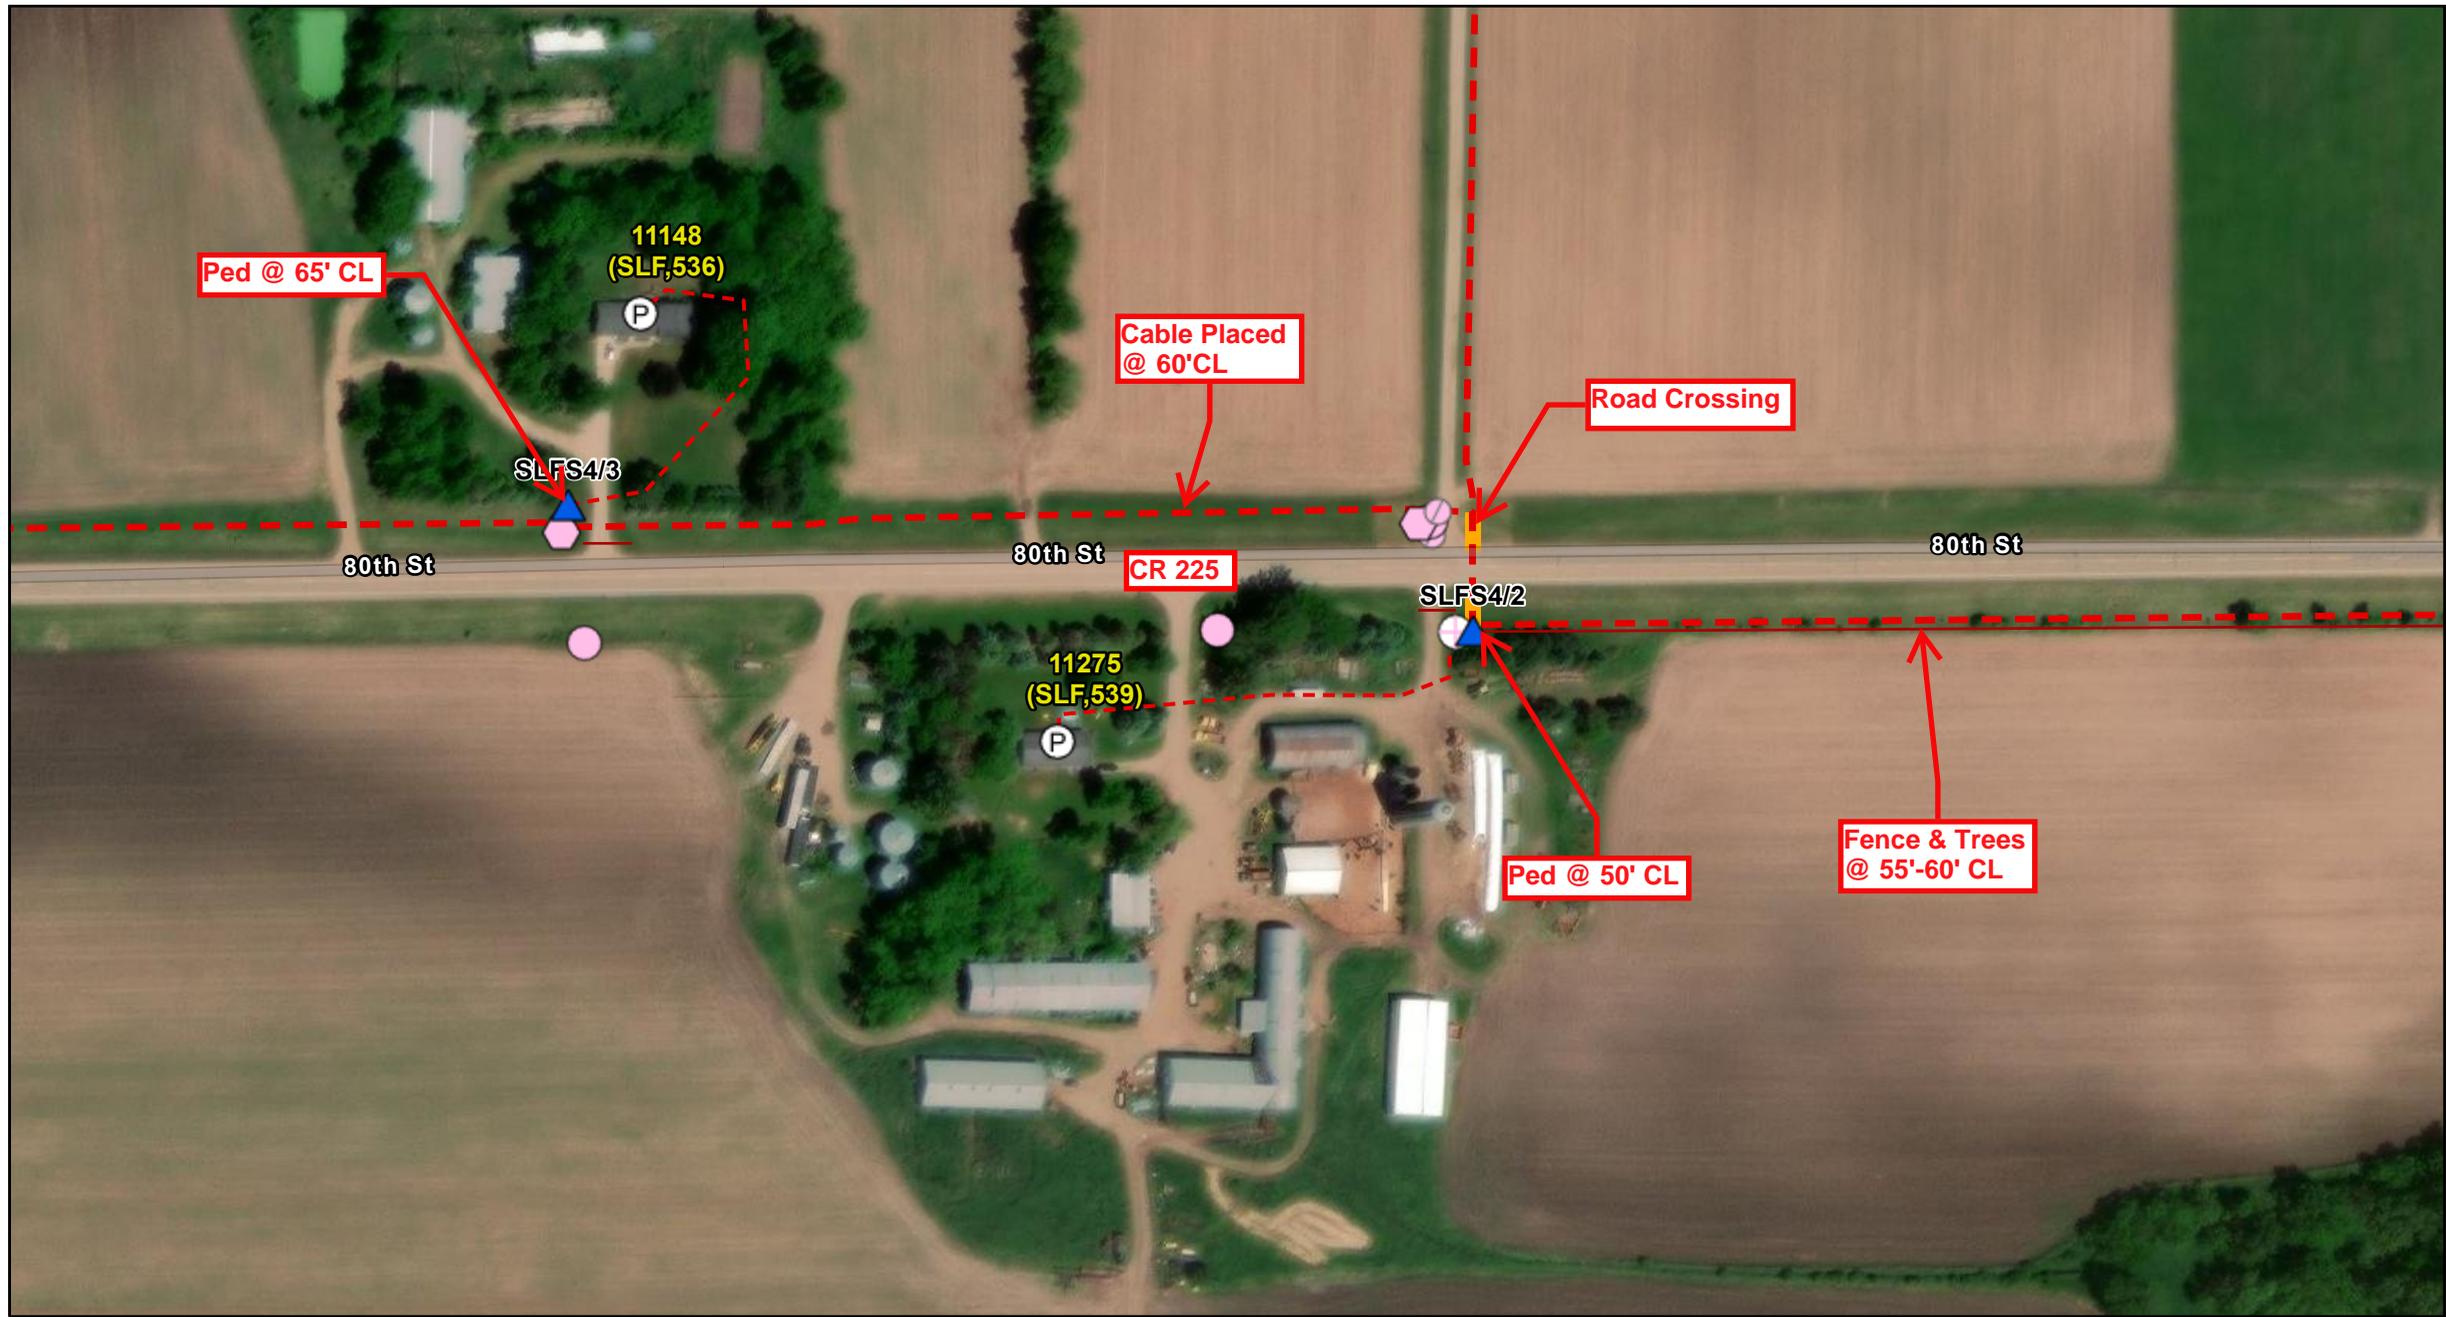

Customer Status	Customer Type	Pedestals	CO and Cabinets	Distribution Fiber Cable	Conduit	Public Waterways
● Active	□ Business	▲ Complete	⬡ Cabinet	— Buried - Existing	— Proposed	— Public Ditch/Altered Natural Watercourse
● Inactive	⊙ Industrial	▲ Proposed	⬡ Central Office	· · · Buried - Proposed	— Existing	— Public Water Watercourse
● Potential	⊞ Multi-Unit	<b>Handhole</b>		<b>Network Fiber Cable</b>		— Public Lakes
● Ready for Cutover	○ Residential	■ Proposed	<b>Service Drop Cable</b>	— Buried - Existing		— Private Easement Area
● Requested		■ Existing	— Buried - Proposed	· · · Buried - Proposed		— Telco Service Area
		— Buried - Existing				

**Project:** CR 225 Pg 3 of 4

Staked By:	Date:	 <b>Cooperative Network Services, LLC</b> 14 Main St SW - Menahga, MN 56464 218-564-3000
Revised By:	Date:	
As Built By:	Date:	

ROW Width: Varies 260 ft Prepared By: ArcGIS Online 1/5/2026



Customer Status	Customer Type	Pedestals	CO and Cabinets	Distribution Fiber Cable	Conduit	Public Waterways
● Active	□ Business	▲ Complete	⬡ Cabinet	— Buried - Existing	— Proposed	— Public Ditch/Altered Natural Watercourse
● Inactive	⊙ Industrial	▲ Proposed	⬡ Central Office	· · · Buried - Proposed	— Existing	— Public Water Watercourse
● Potential	⊙ Multi-Unit	<b>Handhole</b>		<b>Network Fiber Cable</b>		— Public Lakes
● Ready for Cutover	○ Residential	■ Proposed	<b>Service Drop Cable</b>	— Buried - Existing		— Private Easement Area
● Requested		■ Existing	— Buried - Proposed	· · · Buried - Proposed		— Telco Service Area
		— Buried - Existing				



**Project:** CR 225 Pg 4 of 4

Staked By:	Date:	 14 Main St SW - Menahga, MN 56464 218-564-3000
Revised By:	Date:	
As Built By:	Date:	

ROW Width: Varies 260 ft Prepared By: ArcGIS Online 1/5/2026