


Customer Status	Customer Type	Pedestals	CO and Cabinets	Distribution Fiber Cable	Conduit	Public Waterways
Active	Business	Complete	Cabinet	Buried - Existing	Proposed	Public Ditch/Altered Natural Watercourse
Inactive	Industrial	Proposed	Central Office	Buried - Proposed	Existing	Public Water Watercourse
Potential	Multi-Unit	Handhole		Network Fiber Cable		Public Lakes
Ready for Cutover	Residential	Proposed	Service Drop Cable	Buried - Existing		Private Easement Area
Requested		Existing	Buried - Proposed	Buried - Proposed		Telco Service Area
			Buried - Existing	Buried - Existing		
				Buried - Proposed		



**Project:** CSAH 6 Pg 1 of 4

Staked By:	Date:	 <b>Cooperative Network Services, LLC</b> 14 Main St SW - Menahga, MN 56464 218-564-3000
Revised By:	Date:	
As Built By:	Date:	

ROW Width: Varies	280	Prepared By:
		ft ArcGIS Online 1/6/2026

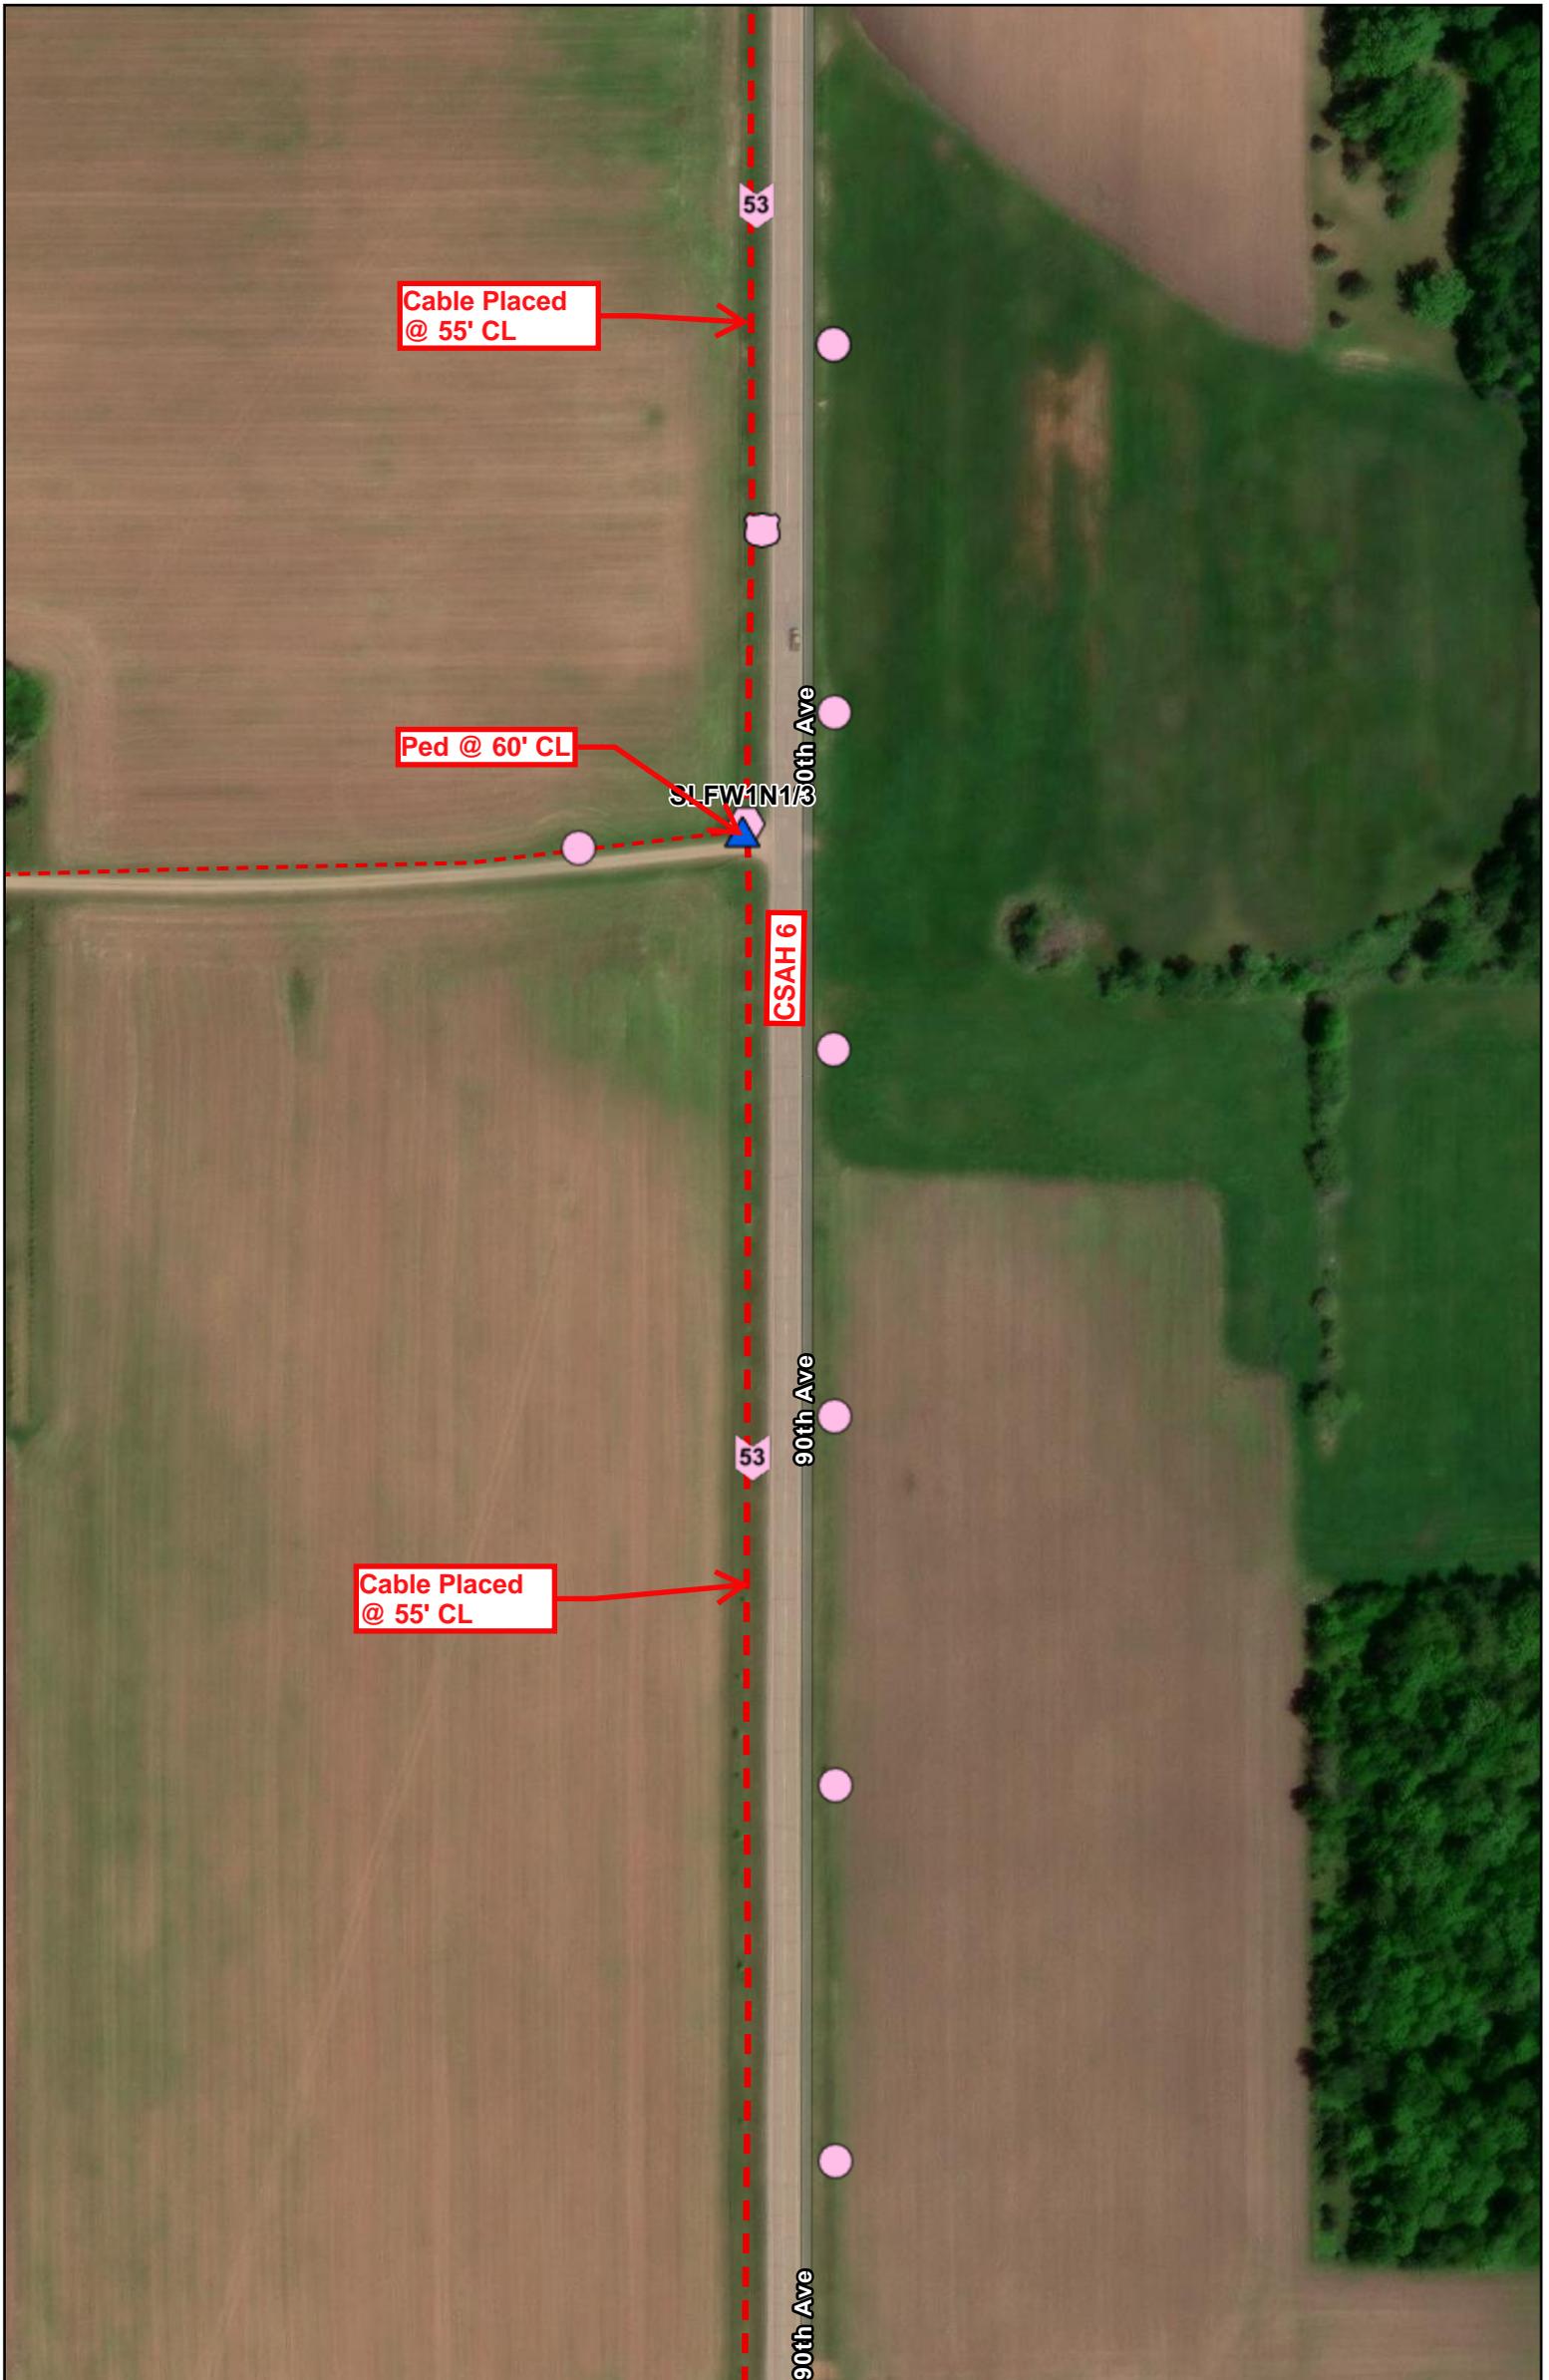


Customer Status	Customer Type	Pedestals	CO and Cabinets	Distribution Fiber Cable	Conduit	Public Waterways
Active	Business	Complete	Cabinet	Buried - Existing	Proposed	Public Ditch/Altered Natural Watercourse
Inactive	Industrial	Proposed	Central Office	Buried - Proposed	Existing	Public Water Watercourse
Potential	Multi-Unit	Handhole	Service Drop Cable	Network Fiber Cable		Public Lakes
Ready for Cutover	Residential	Proposed	Buried - Proposed	Buried - Existing		Private Easement Area
Requested		Existing	Buried - Existing	Buried - Proposed		Telco Service Area



**Project:** CSAH 6 Pg 2 of 4

Staked By:	Date:	 <b>Cooperative Network Services, LLC</b> 14 Main St SW - Menahga, MN 56464 218-564-3000
Revised By:	Date:	
As Built By:	Date:	

ROW Width:	Varies	280	Prepared By:
			ft ArcGIS Online 1/6/2026

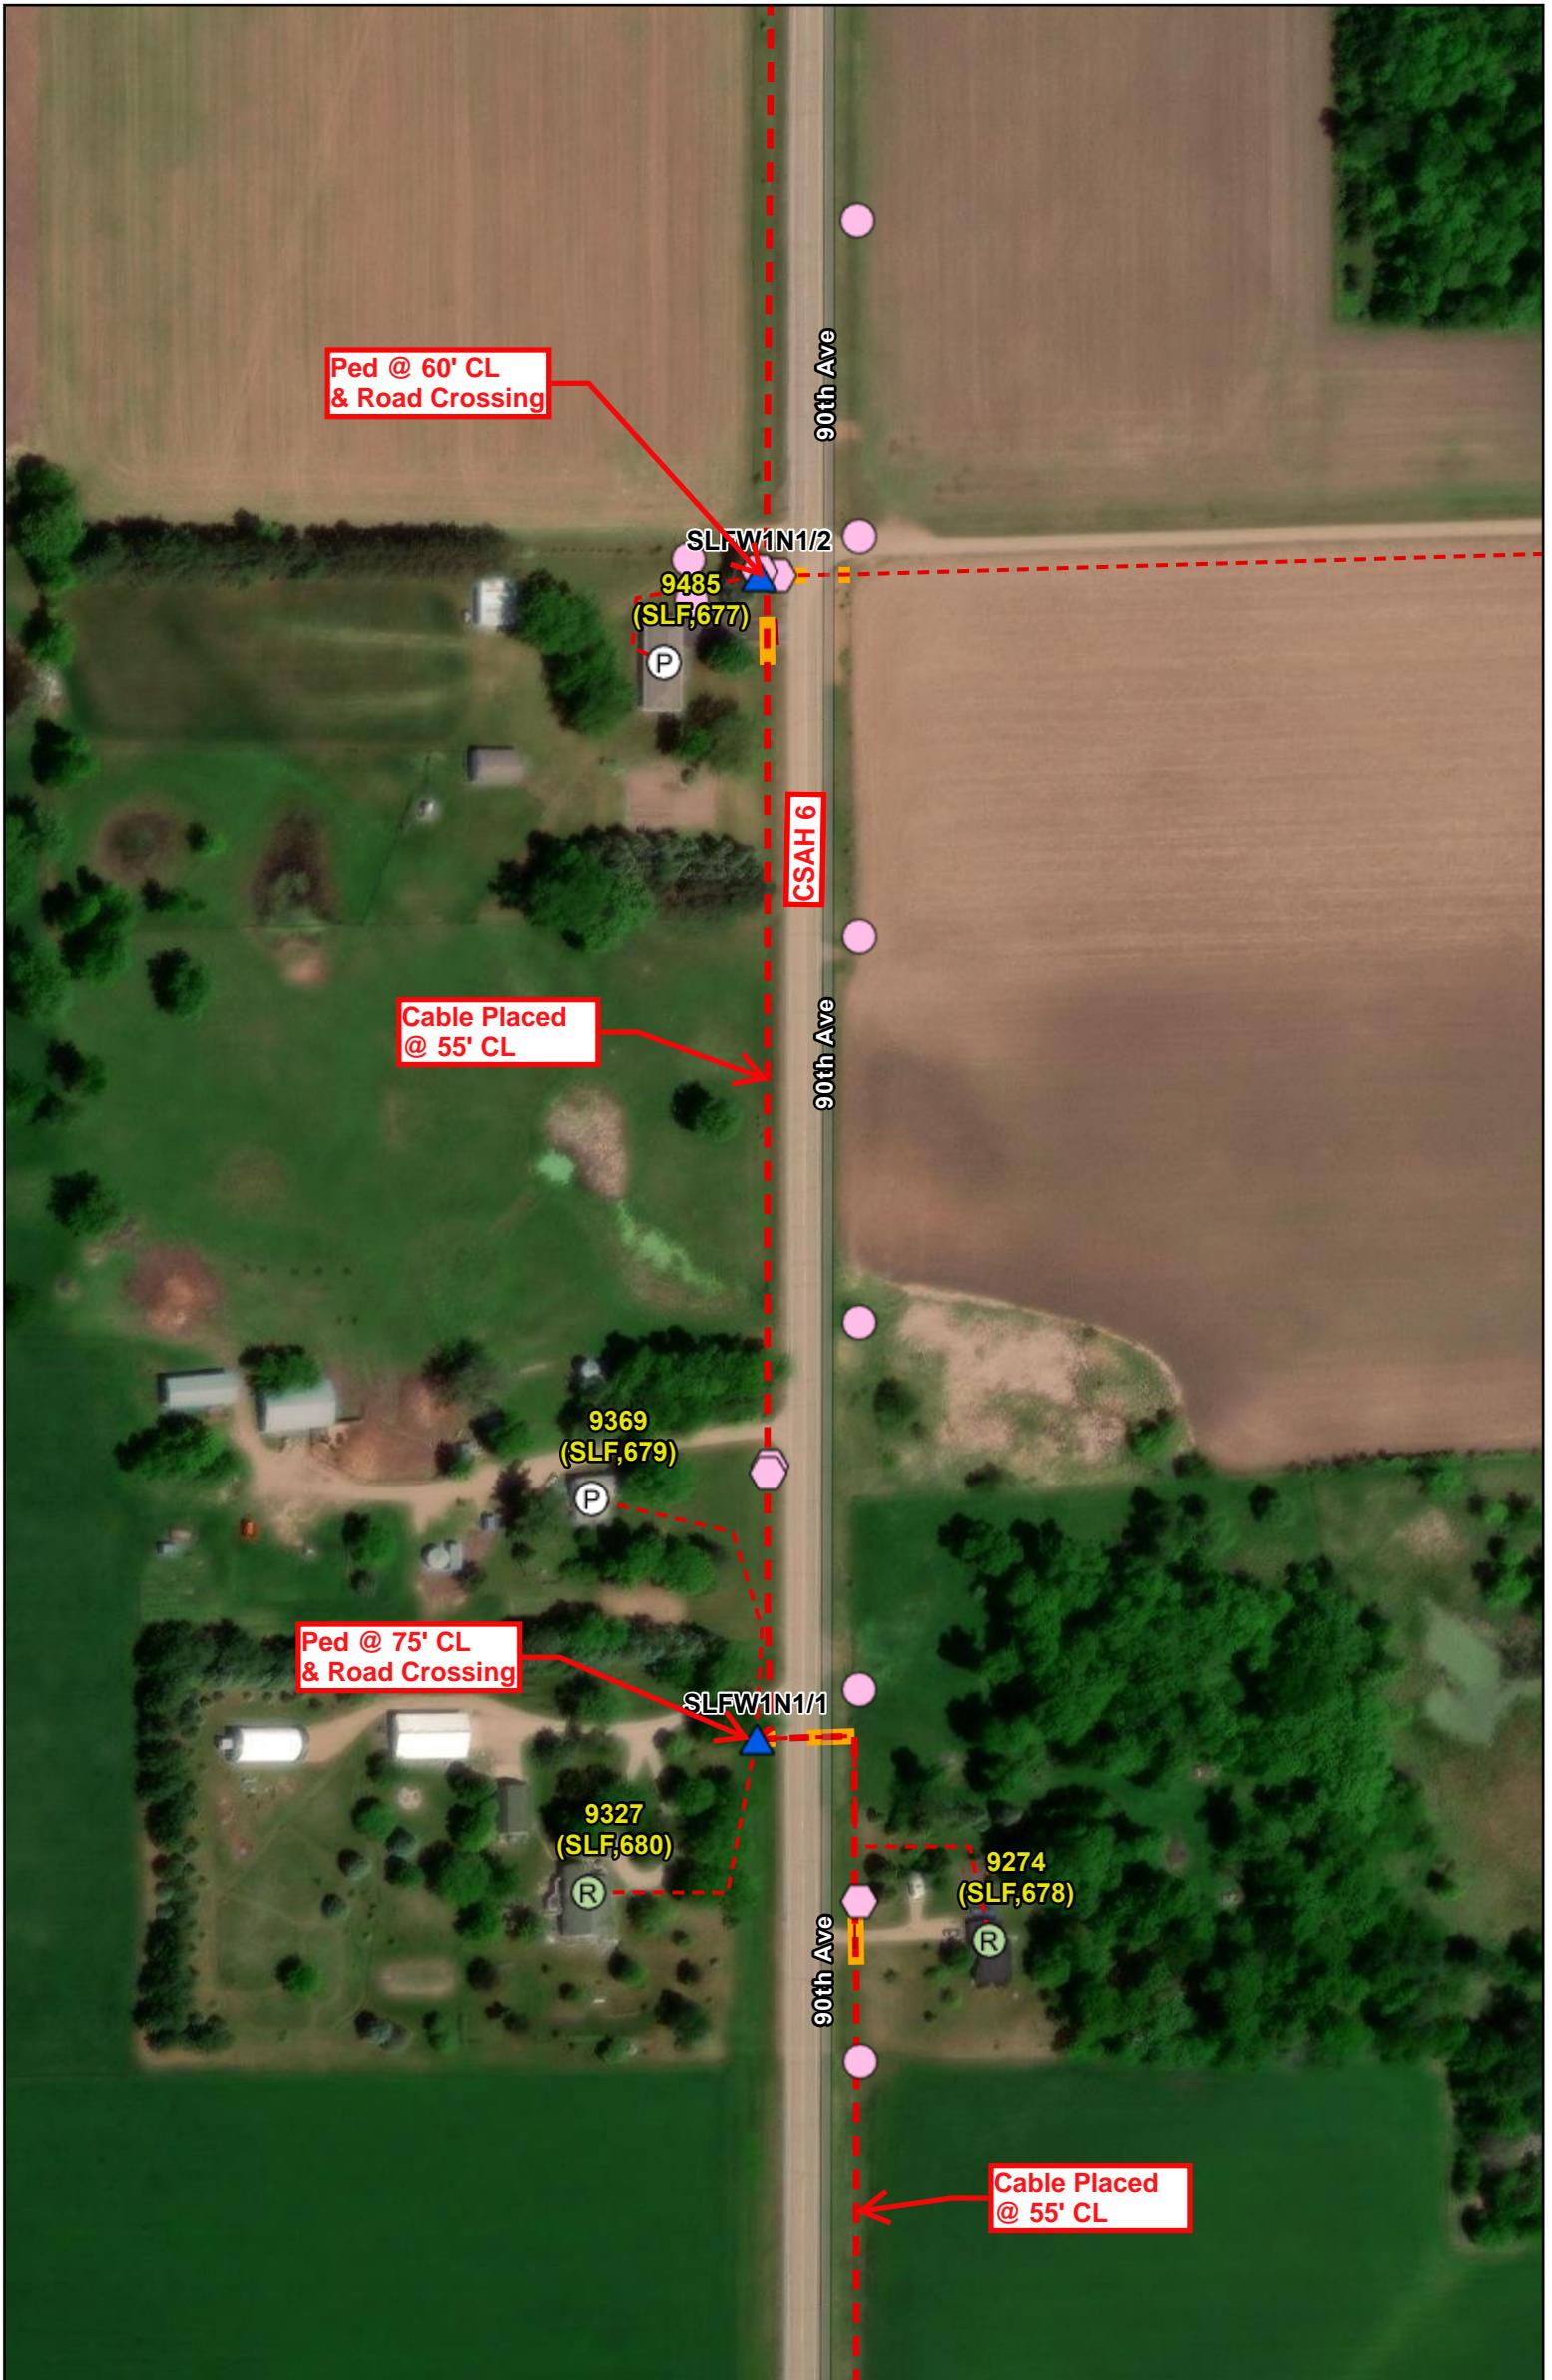

Customer Status	Customer Type	Pedestals	CO and Cabinets	Distribution Fiber Cable	Conduit	Public Waterways
Active	Business	Complete	Cabinet	Buried - Existing	Proposed	Public Ditch/Altered Natural Watercourse
Inactive	Industrial	Proposed	Central Office	Buried - Proposed	Existing	Public Water Watercourse
Potential	Multi-Unit	Handhole	Service Drop Cable	Network Fiber Cable		Public Lakes
Ready for Cutover	Residential	Proposed	Buried - Proposed	Buried - Existing		Private Easement Area
Requested		Existing	Buried - Existing	Buried - Proposed		Telco Service Area



**Project:** CSAH 6 Pg 3 of 4

Staked By:  
Revised By:  
As Built By:

Date:  
Date:  
Date:

**CNS** Cooperative Network Services, LLC  
14 Main St SW - Menahga, MN 56464  
218-564-3000

ROW Width: Varies

280

Prepared By:

ft GIS Online 1/6/2026



Customer Status	Customer Type	Pedestals	CO and Cabinets	Distribution Fiber Cable	Conduit	Public Waterways
Active	Business	Complete	Cabinet	Buried - Existing	Proposed	Public Ditch/Filtered Natural Watercourse
Inactive	Industrial	Proposed	Central Office	Buried - Proposed	Existing	Public Water Watercourse
Potential	Multi-Unit	Handhole		Network Fiber Cable		Public Lakes
Ready for Cutover	Residential	Proposed	Service Drop Cable	Buried - Existing		Private Easement Area
Requested		Existing	Buried - Proposed	Buried - Proposed		Telco Service Area
			Buried - Existing	Buried - Proposed		



**Project:** CSAH 6 Pg 4 of 4

Staked By:	Date:	 <b>Cooperative Network Services, LLC</b> 14 Main St SW - Menahga, MN 56464 218-564-3000
Revised By:	Date:	
As Built By:	Date:	

ROW Width: Varies	280	Prepared By:
		ft ArcGIS Online 1/6/2026