


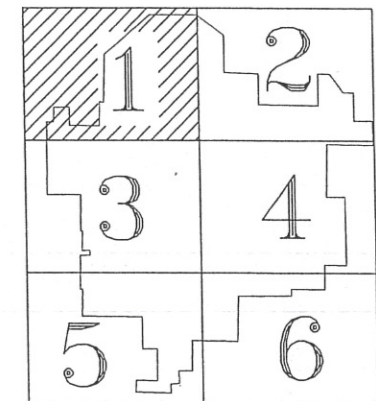


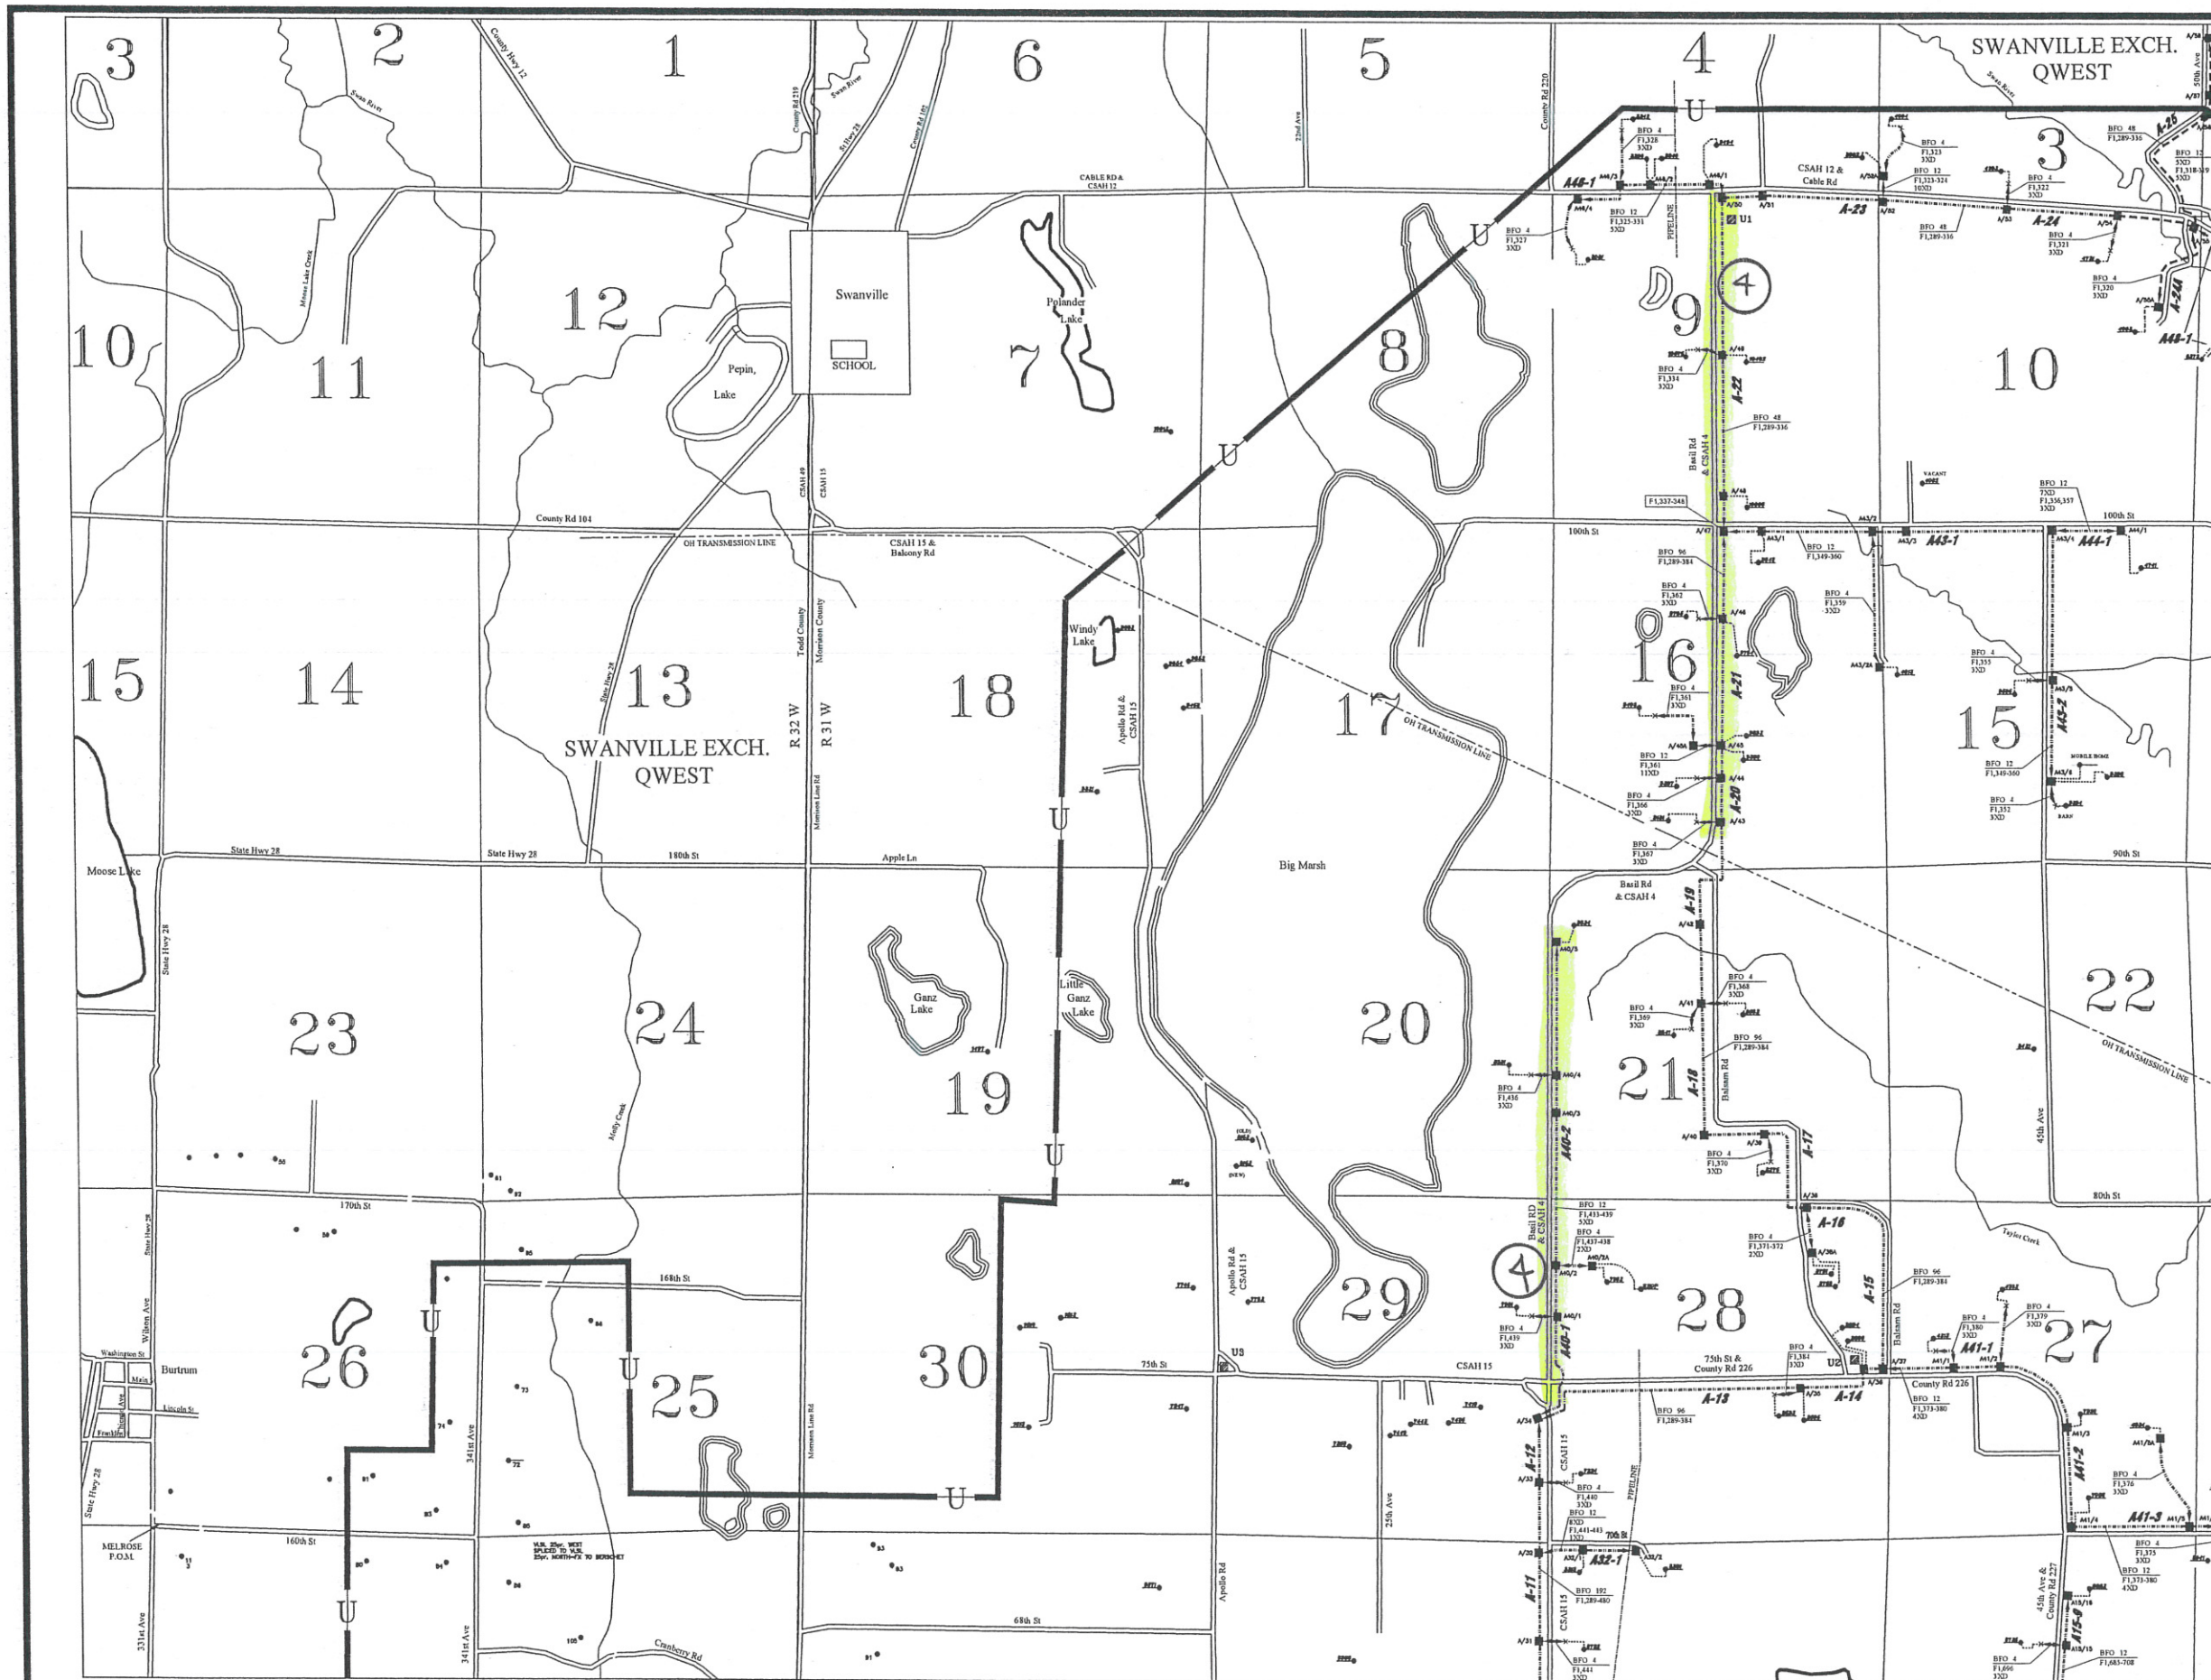


DATE	REVISION AND PURPOSE	DRAWN BY
4-1-12	PROPOSED 2012 CONSTRUCTION	FEC
3-1-12	AS BUILT	FEC

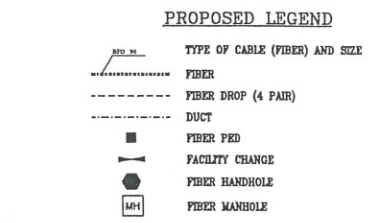


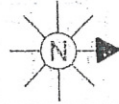

COUNTY MORRISON		SEC. 28	STAKED BY FEC-JM		EXCHANGE UPSALA	LEAD A40
TWP. 128N		RGE. 31W	DATE 2-12	REL. REV.	STAKING SHEET AND PLANT RECORD	SHEET 1 OF 2
PROJECT						MAP REF.

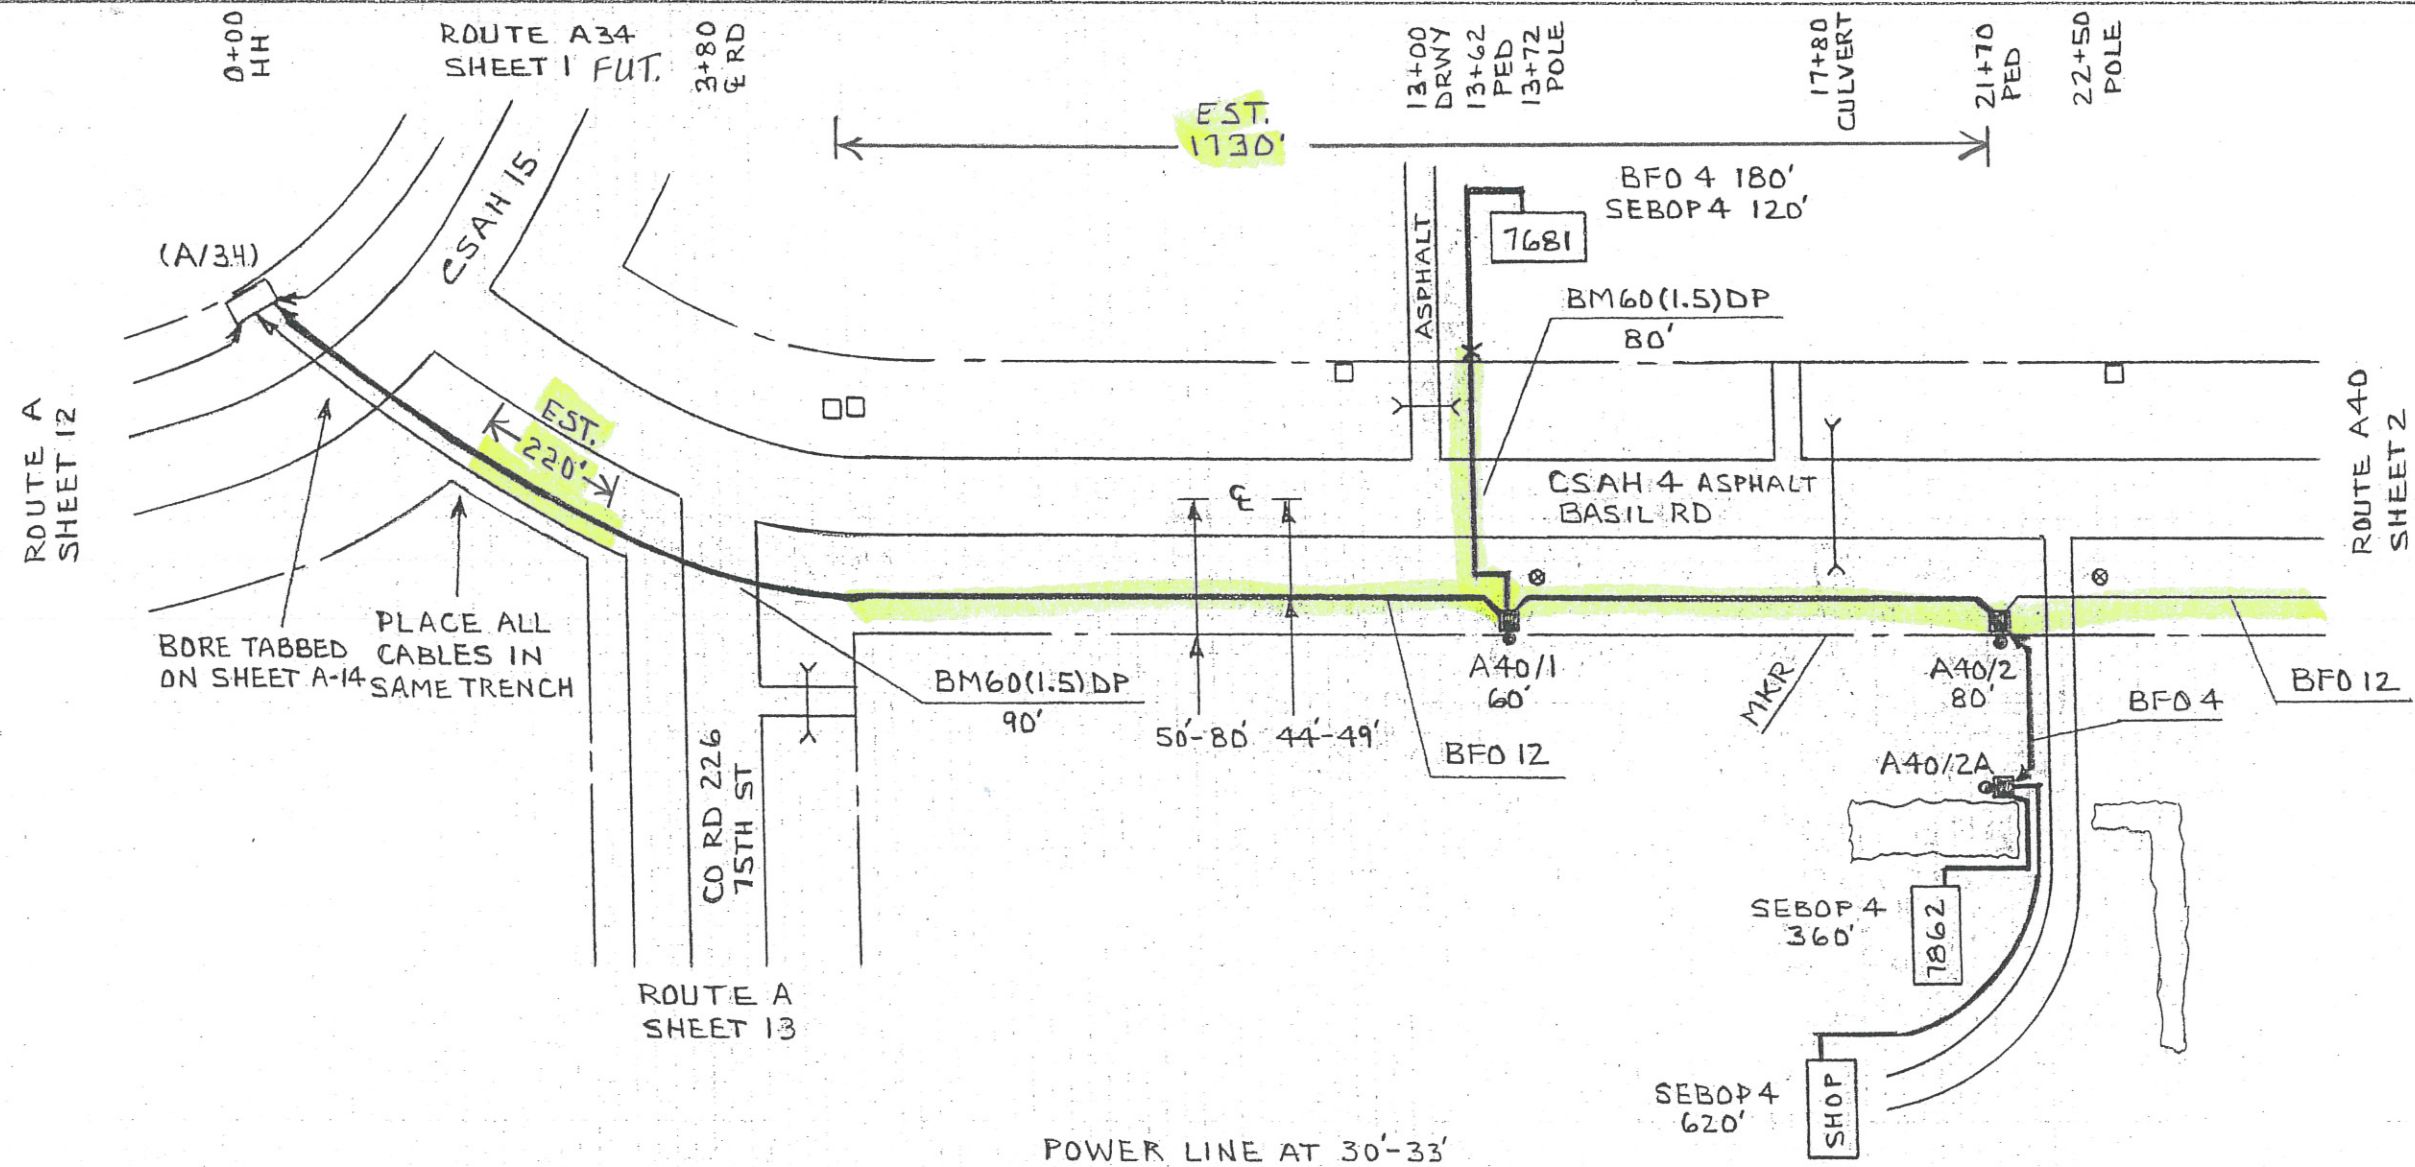


PED OR STA#	PED	POLE	MISC.								SPICE				CABLE						MISC. NOTES				
	BD	BA 23	BDO 8A	BDO 6A			BM2 (5/8X8)	BM S3	BM60 (1.5)DP		BM 83			HO-1			BFO 12	BFO 4				SEBOP 4			
(A/34)																									
A40/1		1		1			1		90					1			1458								
							1		80		1							180			120			1	7681
A40/2		1		1			1	1						2			880								
A40/2A		1		1			1							2				590							
							1				1									360			1	7862	
							1				1									620			1	SHOP	
TOTAL		3		3			6	1	170		3			5			2338	770			1100			3	

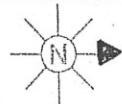


LEAD A40

SHEET 2 OF 2

MAP REF.

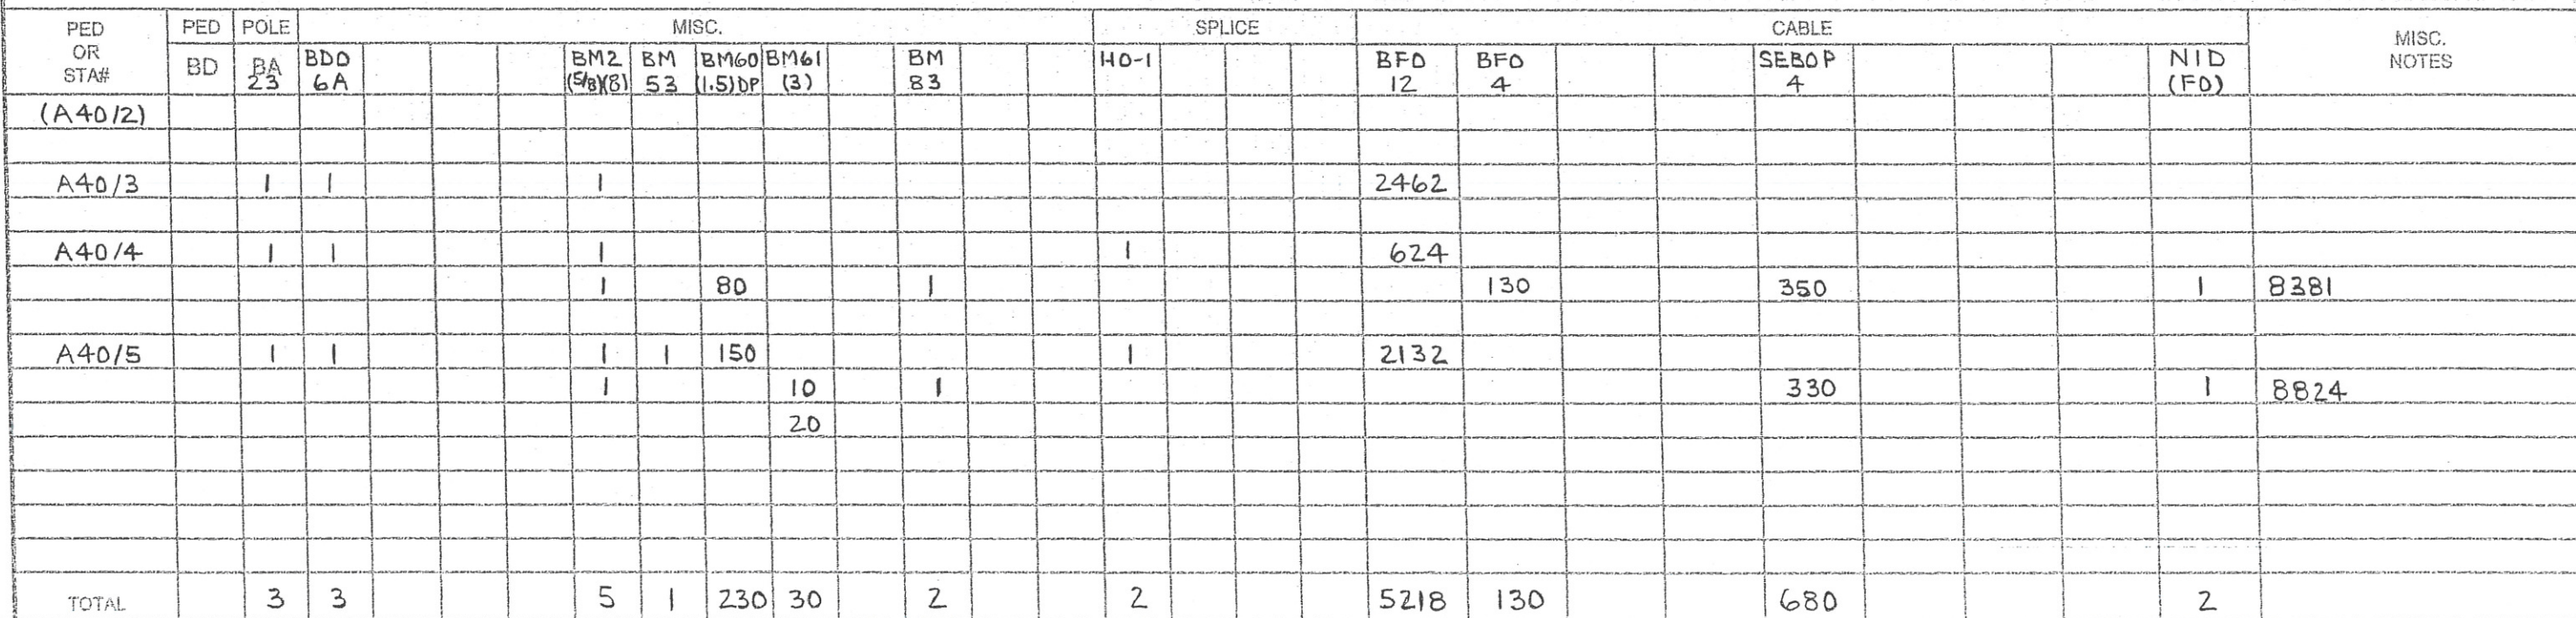


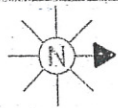


SEC.	16,21	STAKED BY	FEC-JM
TWP.	128N	DATE	3-12
RGE.	31W	REL.	REV.

EXCHANGE	UPSALA
STAKING SHEET AND PLANT RECORD	

LEAD	A
SHEET	19 OF 75
MAP REF.	

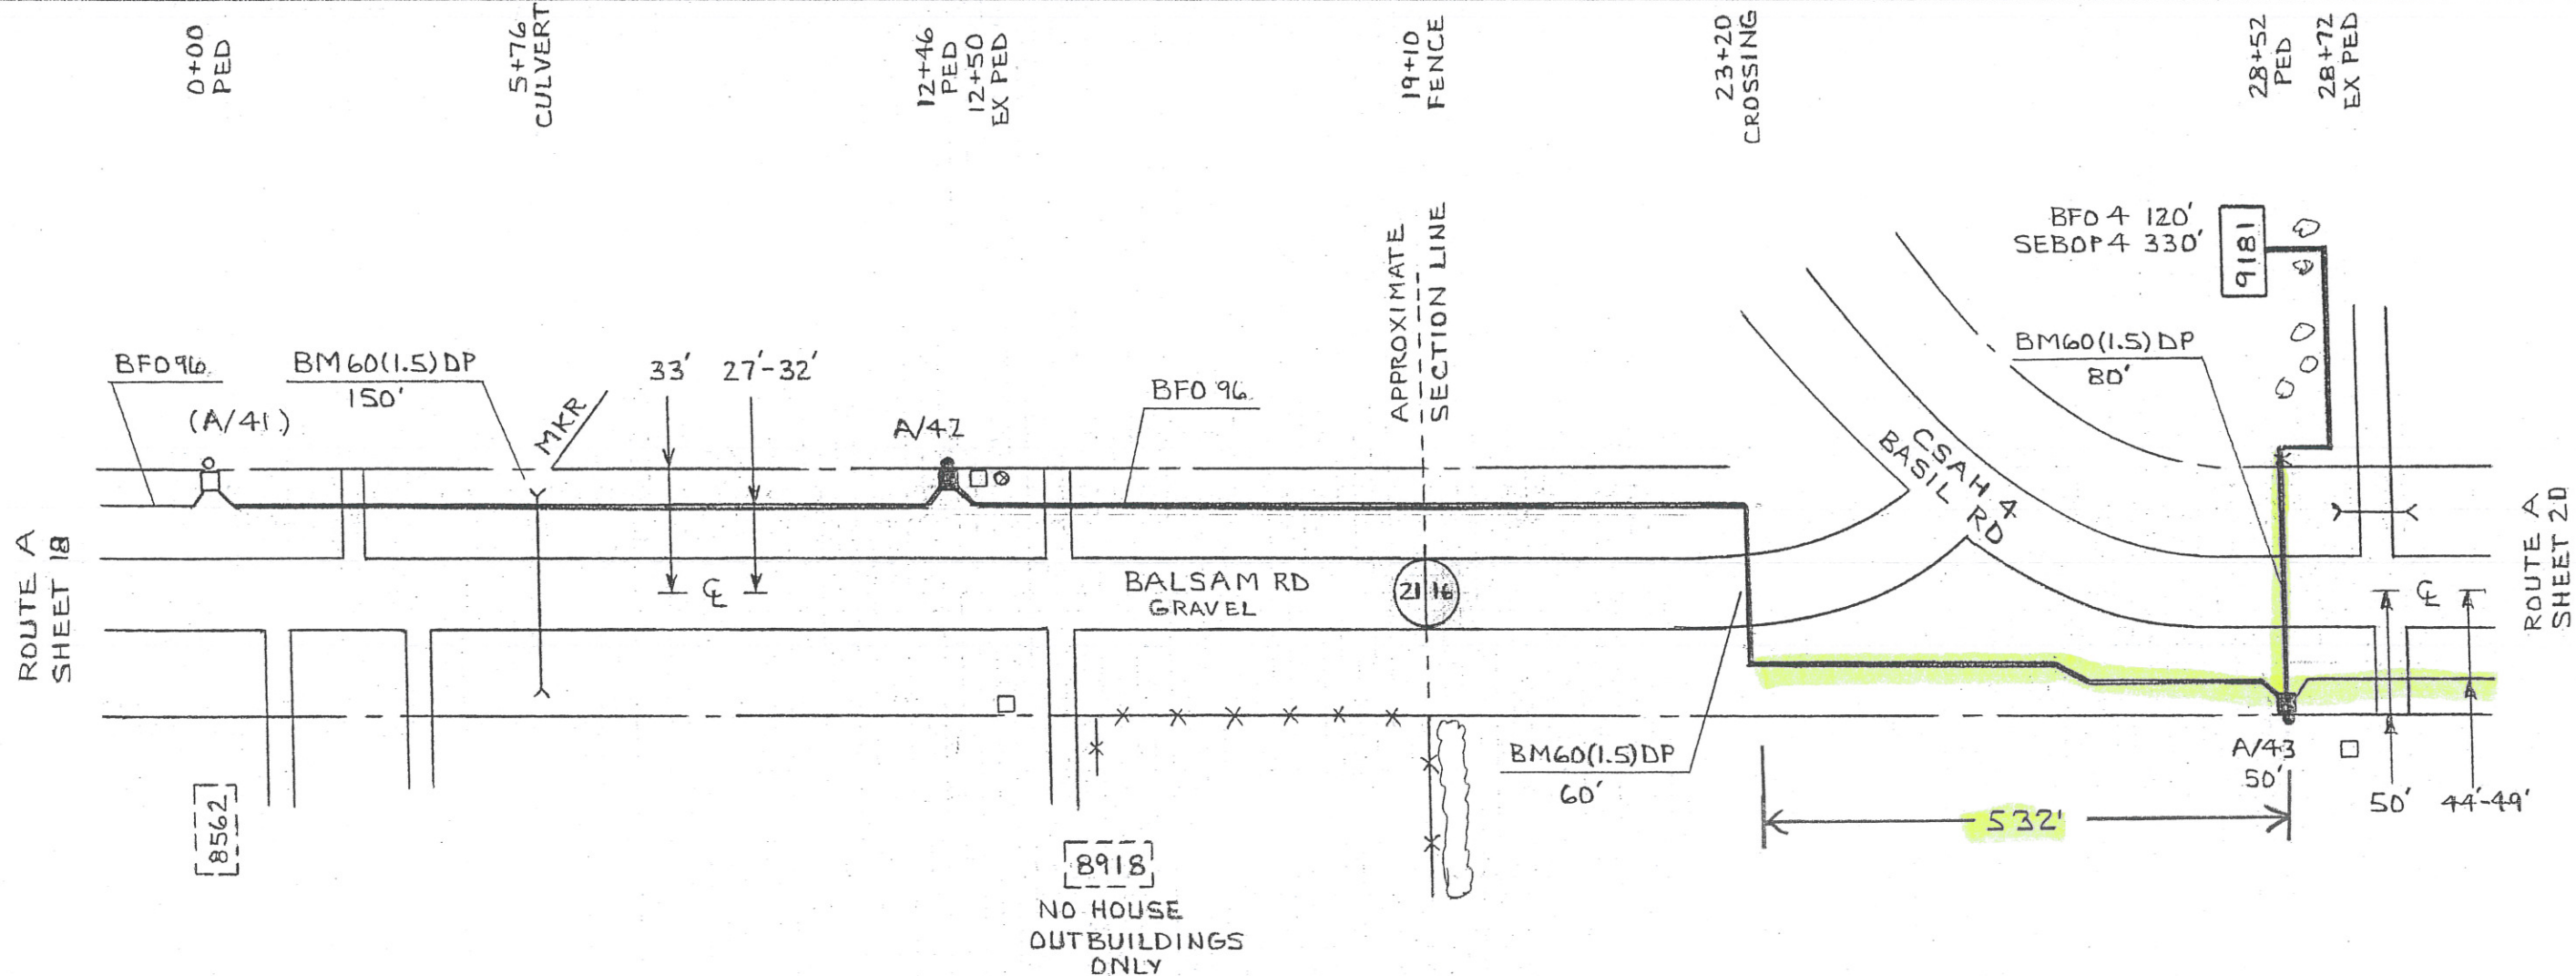[illegible]

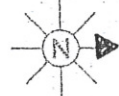


COUNTY MORRISON


SEC. 16 STAKED BY FEC-JM
TWP. 128N DATE 3-12
RGE. 31W REL. REV. PROJECT

EXCHANGE UPSALA
STAKING SHEET AND PLANT RECORD

LEAD A
SHEET 20 OF 25
MAP REF.

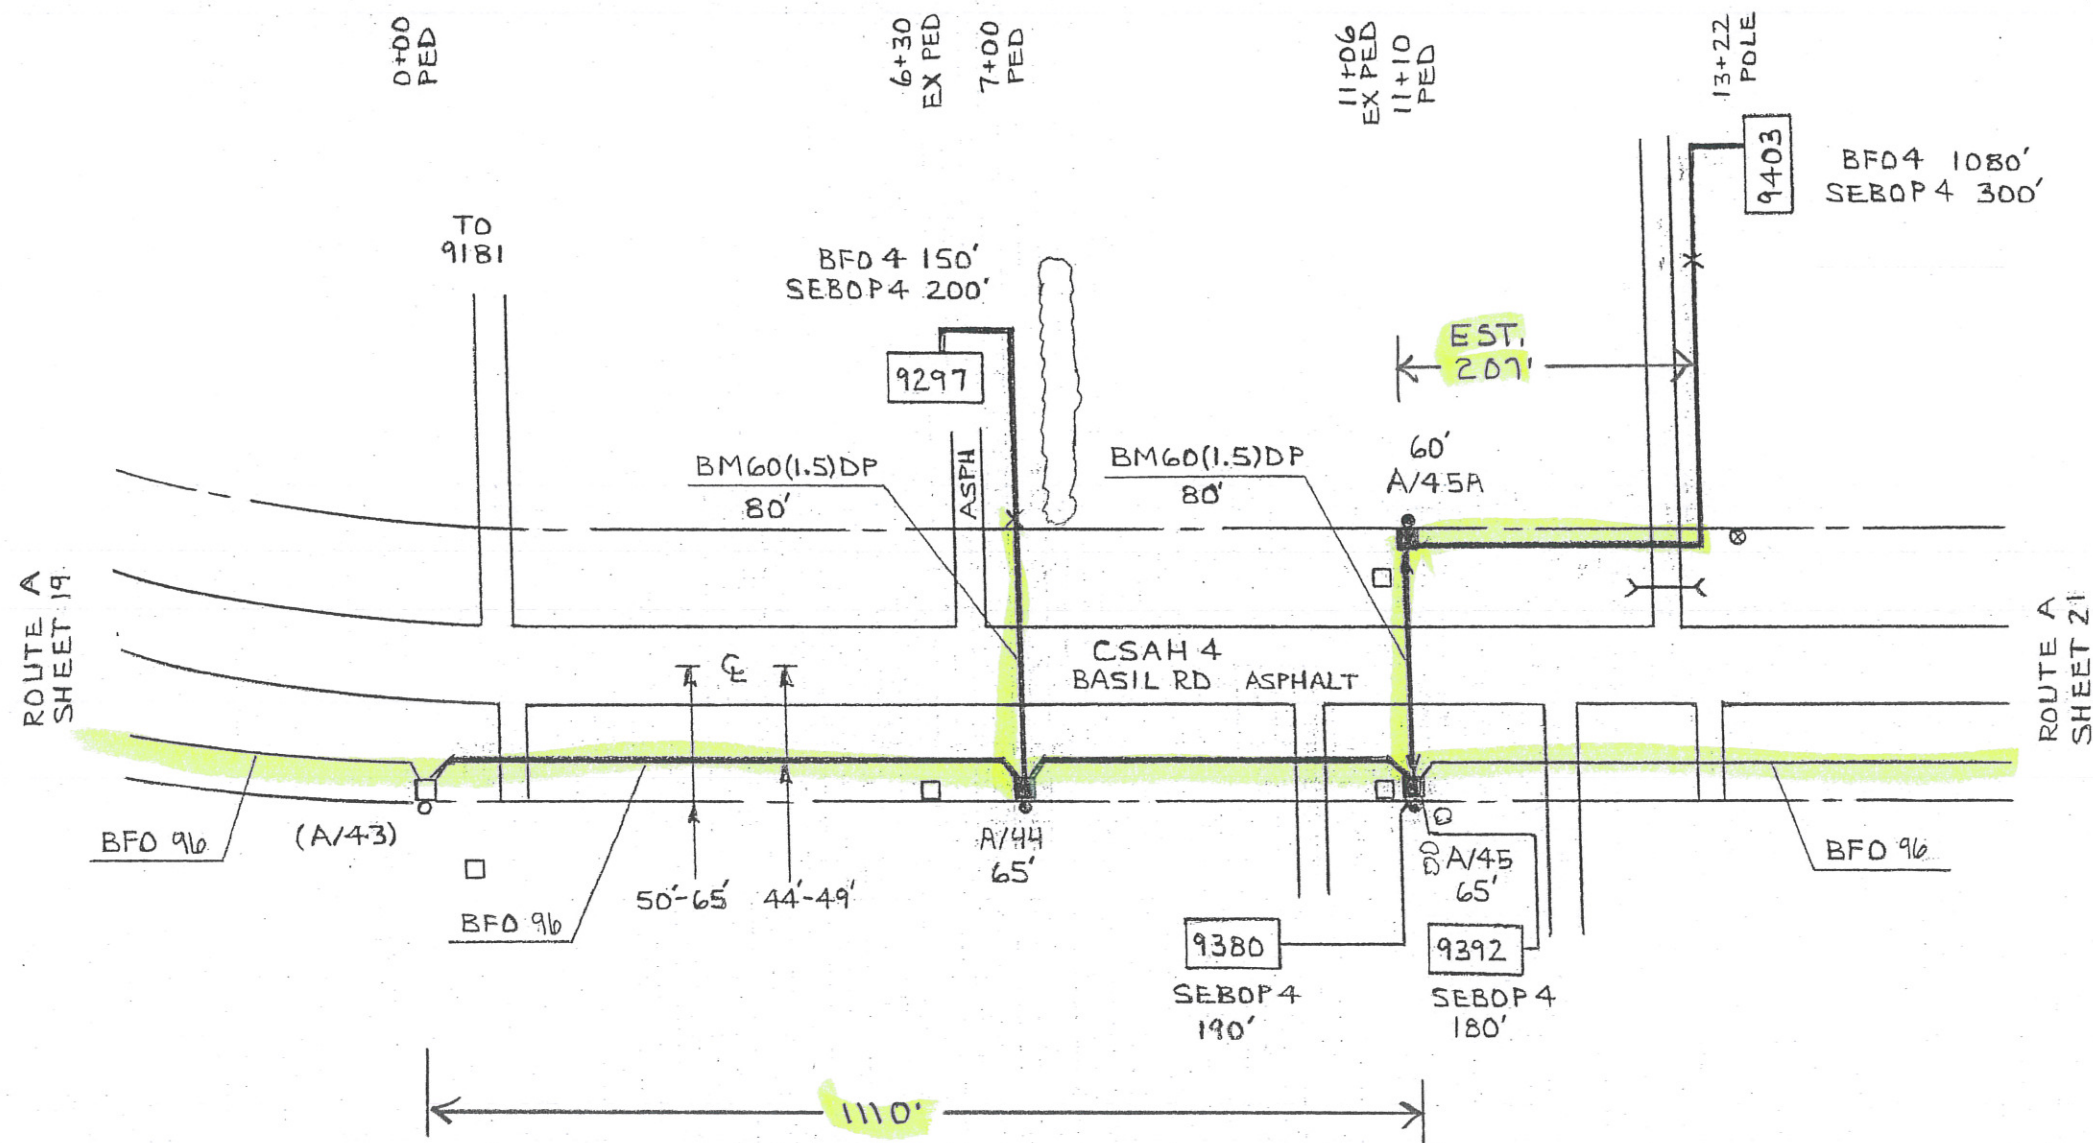

PED OR STA#	PED		POLE		MISC.				SPLICE		CABLE				MISC. NOTES	
	BD	BA	BDO	BDO	BM2	BM60	BM	HO-1			BFO	BFO	BFO	SEBOP	NID	
(A/43)		23	8A	6A	(5/8)(B)	(1.5)DP	83				96	12	4	4	(FO)	
A/44		1	1		1			1			742					
					1	80	1					150	200		1	9297
A/45		1	1		1			3			462					
					1		1						190		1	9380
					1		1						180		1	9392
A/45A		1		1	1	80		1				150				
					1		1					1080	300		1	9403
TOTAL		3	2	1	7	160	4	5			1204	150	1230	870	4	

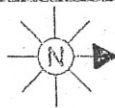

0+00 PED

6+58 CULVERT

TO 9403

20+00 PED
20+18 EX PED

34+00 PED
34+04 EX PED

BFO 4 110'
SEBOP 4 130'

9765

BM60 (1.5) DP
60'

BFO 96

CSAH 4
BASIL RD ASPHALT

ROUTE A SHEET 20

ROUTE A SHEET 22

MIN MAINT RD

100TH ST

ROUTE A43 SHEET 1

BFO 96

(A/45)

9392

MKR

BM60 (1.5) DP
180'

BFO 96

A/46 50'

SEBOP 4 350'

9764

BM60 (1.5) DP
40'

50'-105'

44'-49'


A/47 60'

BFO 12

BFO 48

3400'

PED OR STA#	PED	POLE	MISC.										SPLICE				CABLE						MISC. NOTES				
	BD	BA 23	BDO 8A				BM2 (5/8)8	BM 53	BM60 (1.5)DP			BM 83			H0-1			BFO 96	BFO 4			SEBOP 4					NID (FO)
(A/45)																											
A/46		1	1				1	1	180						2			2048									
											1											350				1	9764
							1				1								110			130				1	9765
A/47		1	1				1								60			1440									

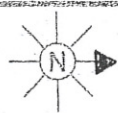


COUNTY MORRISON



SEC. 9 STAKED BY FEC-JM
TWP. 128N DATE 3-12
RGE. 31W REL. REV. PROJECT

EXCHANGE UPSALA
STAKING SHEET AND PLANT RECORD


LEAD A
SHEET 22 OF 25
MAP REF.

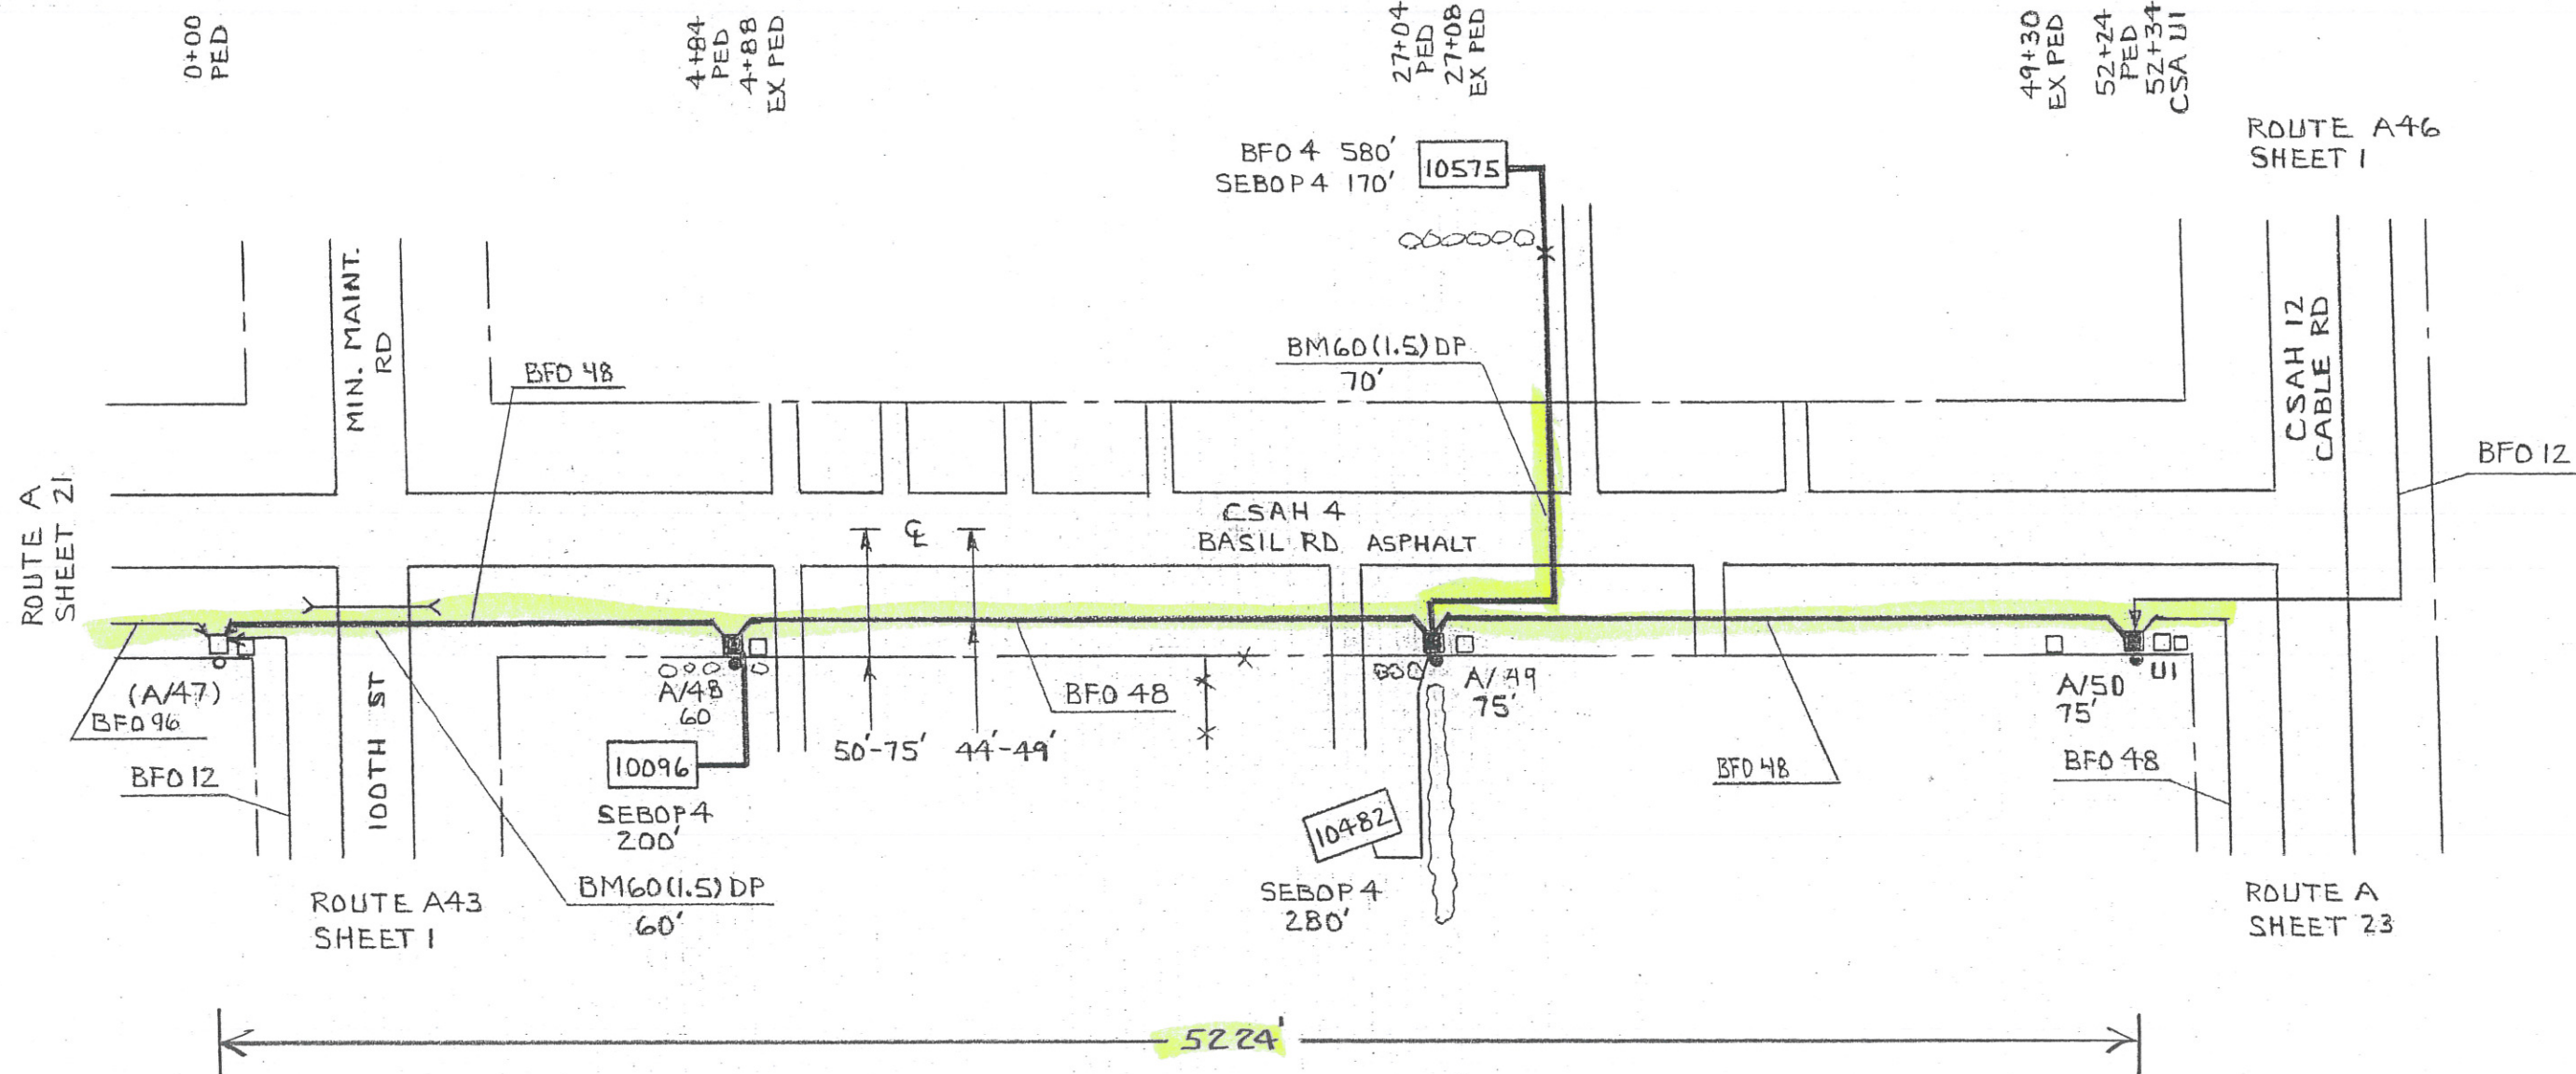

PED OR STA#	PED		POLE		MISC.				SPLICE		CABLE				NID (FO)	MISC. NOTES
	BD	BA 23	BDO BA	BDO BA	BM2 (5)(8)	BM60 (1.5) DP	BM 83	HD-1	BFO 48	BFO 4	SEBOP 4					
(A/47)																
A/48		1		1	1	60		1	538						1	10096
A/49		1		1	1			2	2288							
					1	70	1			580	280				1	10482
											170				1	10575
A/50		1	1		1			7	2602							
TOTAL		3	1	2	5	130	3	10	5428	580	650				3	

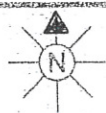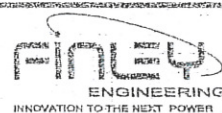

COUNTY MORRISON	SEC. 9.10	STAKED BY FEC-JM	EXCHANGE UPSALA		LEAD A
	TWP. 128N	DATE 3-12	STAKING SHEET AND PLANT RECORD		SHEET 23 OF 25
	RGE. 31W	REL. REV.	PROJECT		MAP REF.

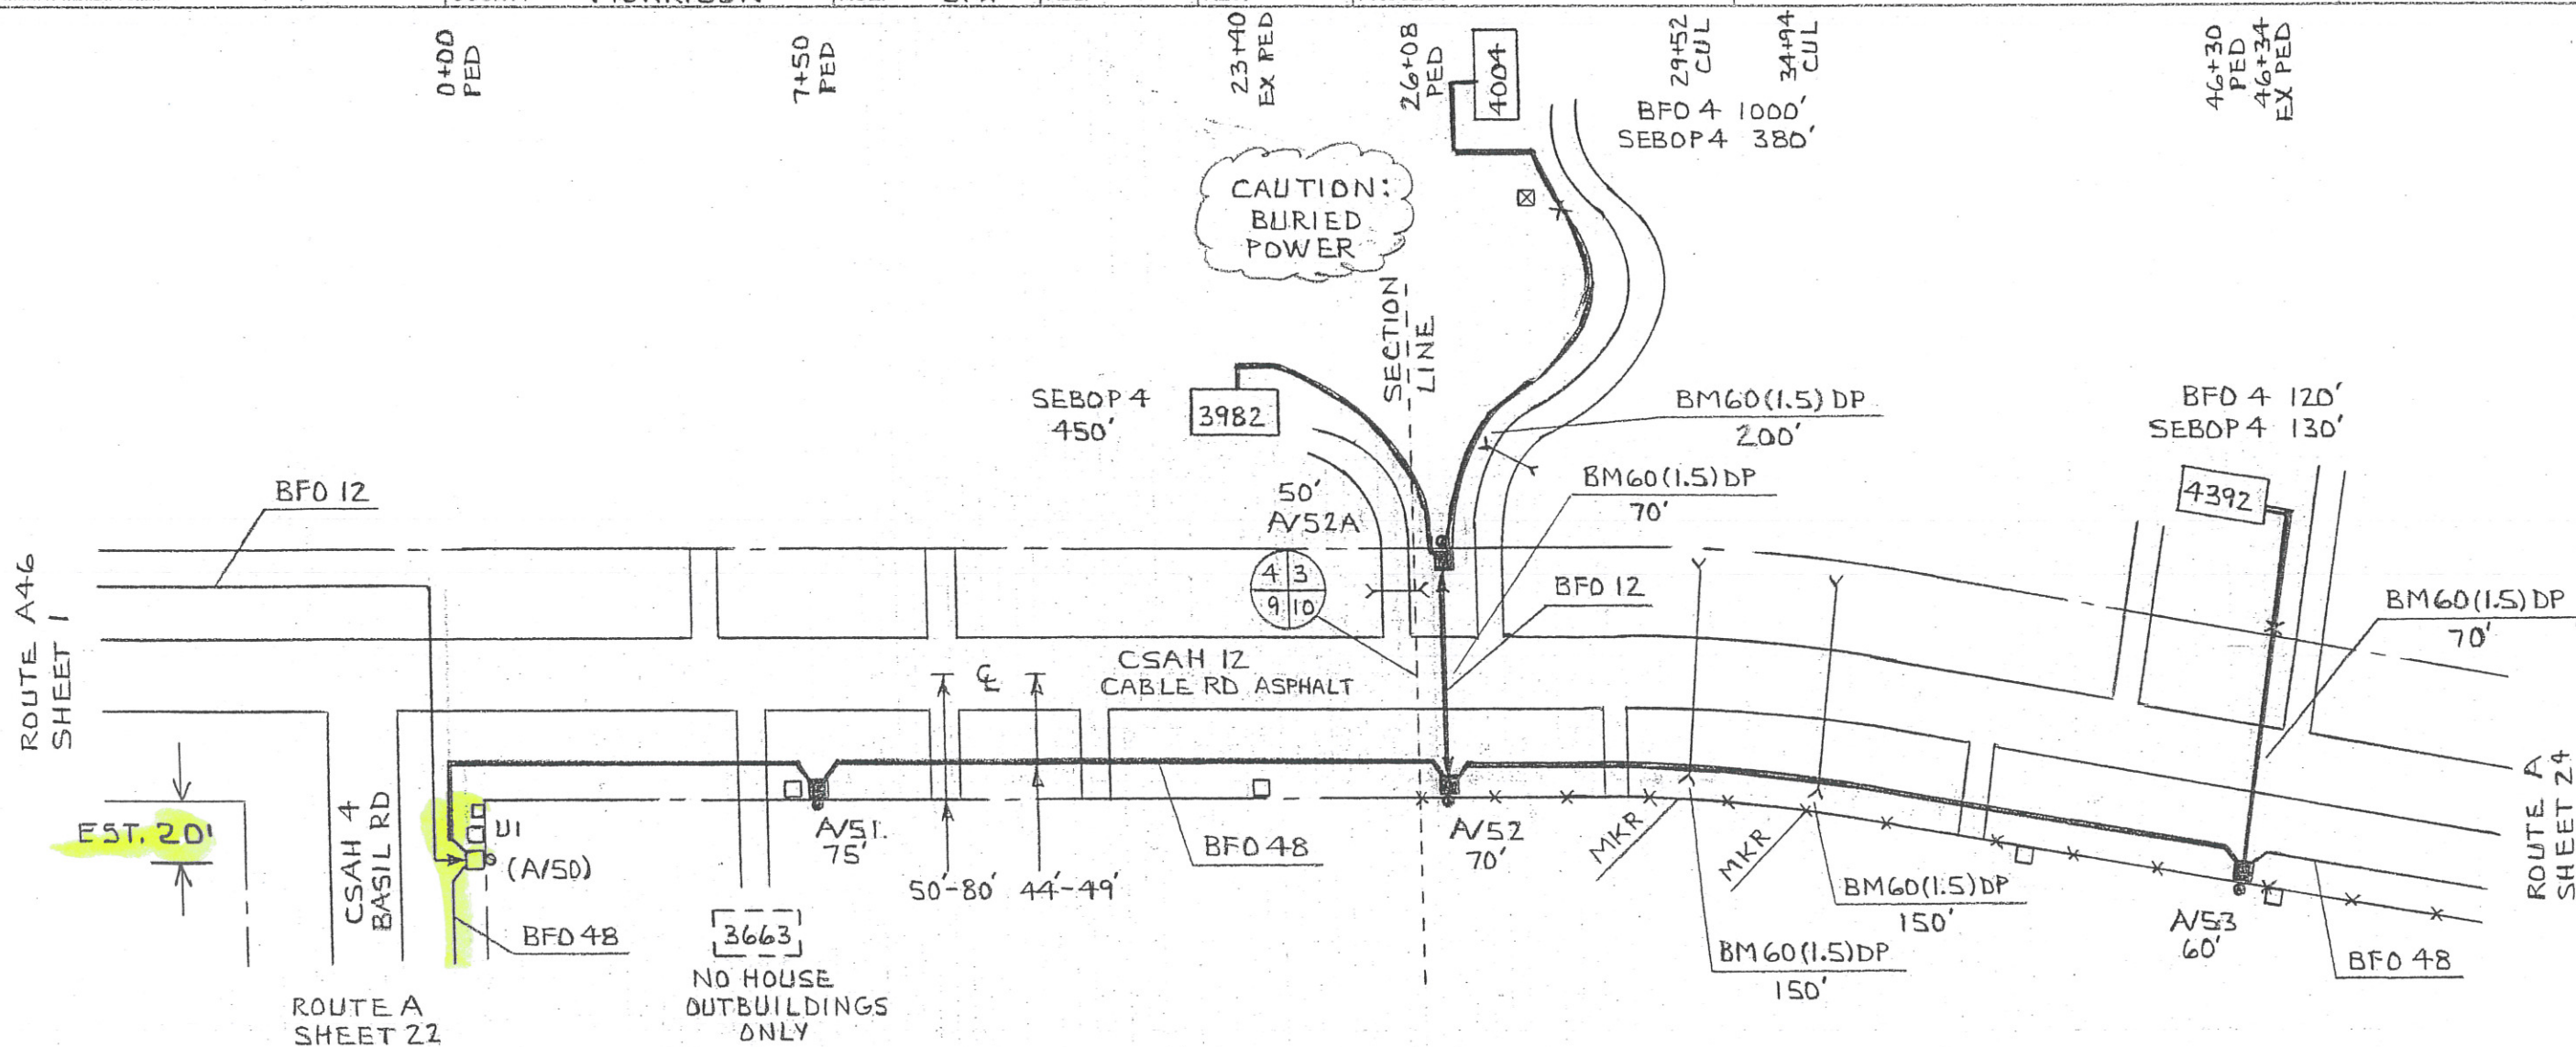

PED OR STA#	PED	POLE	MISC.										SPLICE				CABLE								MISC. NOTES		
	BD	BA 23	BDO 8A	BDO 6A			BM2 (5/8)(8)	BM 53	BM60 (1.5)DP		BM 83			HO-1				BFO 48	BFO 12	BFO 4		SEBDP 4					NID (FO)
(A/50)																											
A/51		1		1			1											828									
A/52		1		1			1							2				1936									
A/52A		1		1			1		70					2					144								
							1				1											450			1	3982	
							1		200		1									1000		380			1	4004	
								1	150																		
A/53		1		1			1	1	150					1				2084									
									70		1									120		130				1	4392
TOTAL		4		4			6	2	640		3			5				4848	144	1120		960				3	