

GAS ASBUILT

Address: 21 1st St. Swanville


Property:

WO: 13 SC - SW - 81 - SWS - 5065 -

CHURET

White Flag

Flagged 9/16/13

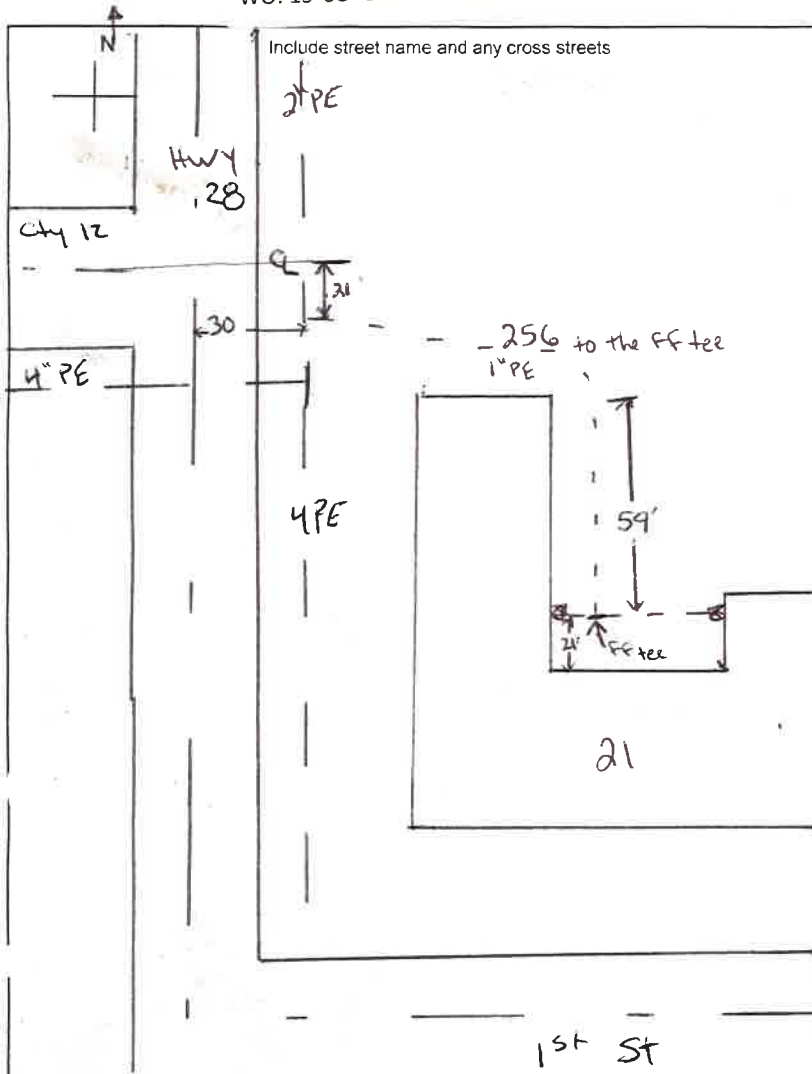

Remarks:

4" Bore Under a Sidewalk
1" PE 1/2" Astm D2513

Material List	Lot #	Qty
Pipe 5/8" or 1"	See Remarks	256
Tee 2x5/8 or 2x1		1
Tee 4x5/8 or 4x1		
Tee 6x5/8 or 6x1		
EFV 5/8 or 1"		1
2 5/10 or 12 # Meter Bar		1
Cplg 5/8 or 1" or 2" 1	Bracket - post - Foundtn.	1
Split Bolt 1	Riser 5/8 or 1"	1
5/8 or 1" ELL	Cap 5/8 or 1"	
PE Tee 5/8 or 1"	PE Reducer (5/8x1")	1
Carsonite	Anode 3#	
# of Heaters	Restoration Y N	

Meter	
Locked ☐	Unlocked ☒
Size 250 x 15	Location East
MFG Sensus	Reading 0000
New Meter # 18171121	
Reg. Type/Press. 2#	5# 10# 12#
Old Meter#	
Old Meter Reading:	

Does Winter Construction Apply? Y ☐ N ☐

Condition of Existing Pipe		
Outside	Inside	Coating
Good ☐	☐	☐
Fair ☐	☐	☐
Bad ☐	☐	☐
Anode #	MV Reading	

Existing Main	
Size 2	Pressure 100 Type/Mfr Dura-Line
Lot #	Cover 36 Location
New Service / Main	
Size 1	Lot # See Remarks
Poly Mfr Dura-Line	Nature of Soil Sandy Rock
Tap Size	Cover 30 Completion Date 9-16-13
Foreman ID 5578	Welder/Fuser ID 7945
Pressure Test	
Test With: Air ☒ Nitrogen ☐	Duration 30 Emp ID 7945
Date Tested 9-16-13 PSI 152	Soap Test Final Tie-in? Y ☒ N ☐
Filled out by Mapping Dept.	
Mapped in System Maps	Date
Mapped in GIS	Date
Entry Person	Date
GSOC Polygon Available	Yes No

Description	Install Footage
Directional Bore	
Pneumatic Bore	4
Backhoe	
Inserting	
Trench	
Plow	252
Hand Digging	
Splitting	
Joint Trench	
Gopher Pipe	
Cust. Perf. Loc.	