

GAS ASBUILT

13 SC

13284 2461 W.O.#

7

STREET ADDRESS

SW 90

10-15-13

128

Swanville 5267

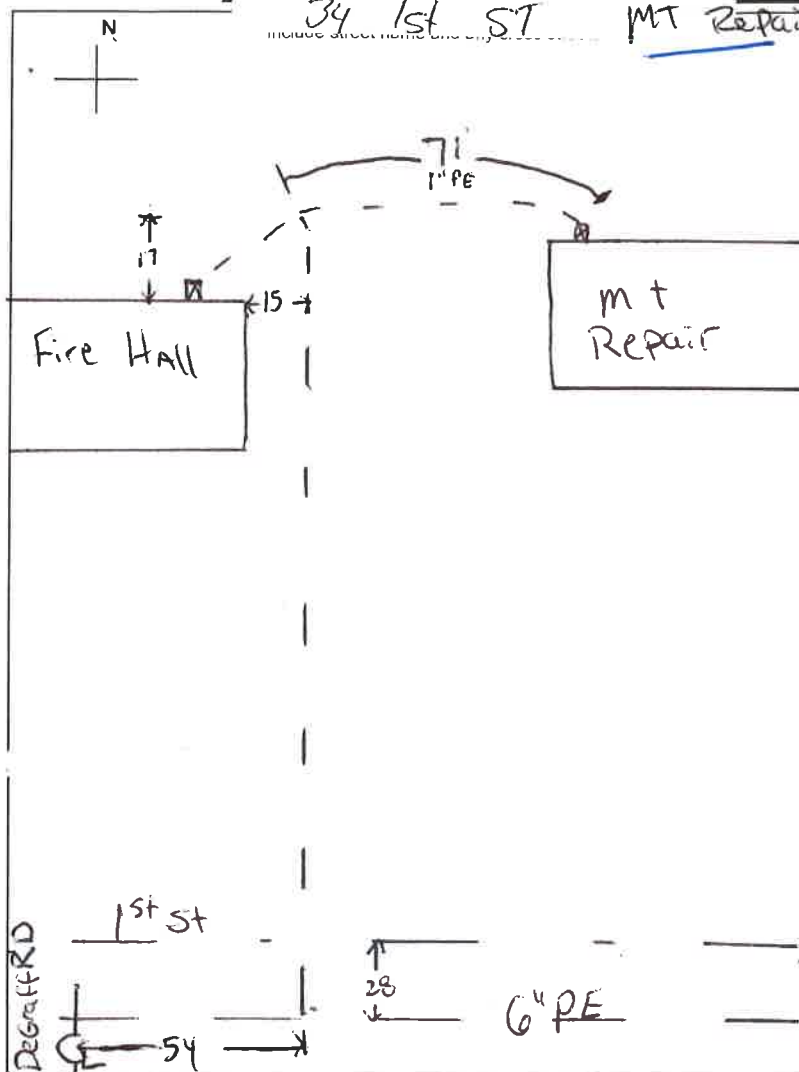
3:00

R 31

34 1st ST

MT Repair

MS 10-11

Pipe & Fitting Type ☒ High D ☐ Medium D

Material List	Lot #	Qty
Pipe 5/8" or 1"	See Remarks	71
Tee 2x5/8 or 2x1		
Tee 4x5/8 or 4x1		
Tee 6x5/8 or 6x1		
EFV 5/8 or 1"		
2, 5, 10 or 12 # Meter Bar		1
Cplg 5/8 or 1" or 2"	Bracket (post) Foundtn.	1
Split Bolt ①	Rise 5/8 or 1"	1
5/8 or 1" ELL	Cap 5/8 or 1"	
PE Tee 5/8 or ①"	PE Reducer 5/8x1"	1
Carsonite	Anode 3#	
# of Heaters	Restoration	Y ☐ N ☐

Meter			
Locked ☐	Unlocked ☒		
Size 415	Location North		
MFG Sensus	Reading 0000		
New Meter # 18292659			
Reg. Type/Press. ②#	5#	10#	12#
Old Meter#			
Old Meter Reading:			
Does Winter Construction Apply?	Y ☐	N ☐	

Remarks:

1" PE CFE Asst m 02513 WED 1640336A 16 Feb 13 COI 10000115

Existing Main			
Size 6	Pressure 100	Type/Mfr Dura-Line	
Lot #	Cover 36	Location	
New Service / Main			
Size 1	Lot # See Remarks		
Poly Mfr Dura-Line	Nature of Soil Sandy		
Tap Size EF	Cover 30	Completion Date 10-16-13	
Foreman ID 5578	Welder/Fuser ID 7945		
Pressure Test			
Test With: Air / Nitrogen	Duration 30	Emp ID 7945	
Date Tested 10-16-13	PSI 152	Soap Test Final Tie-in? Y ☒ N ☐	
Filled out by Mapping Dept.			
Mapped in System Maps	Date		
Mapped in GIS	Date		
Entry Person	Date		
GSOC Polygon Available	Yes	No	

Condition of Existing Pipe		
Outside	Inside	Coating
Good ☐	☐	☐
Fair ☐	☐	☐
Bad ☐	☐	☐
Anode #	MV Reading	
Description	Install Footage	
Directional Bore		
Pneumatic Bore		
Backhoe		
Inserting		
Trench		
Plow	71	
Hand Digging		
Joint Trench		
Gopher Pipe		
Cust. Perf. Loc.		
Permit Required	Y ☐	N ☐