

GAS ASBUILT


Address: 103 Cable Rd. Swanville

Property: Lot 18A Block 002 City 9/19

WO: 13- SN - SW - 81 - SWS - 5057 -

132601874 L/S Flagged 9/6 C.S.

White Flag

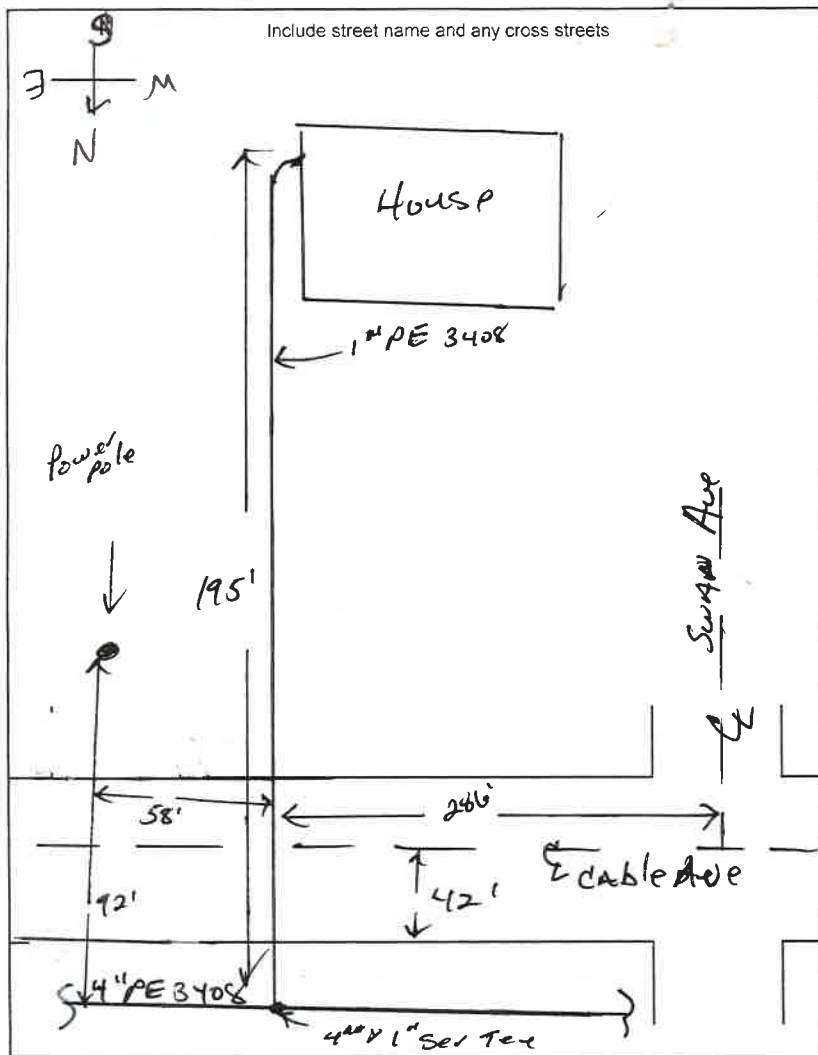

Remarks:

Material List	Lot #	Qty
Pipe 5/8" or 1"	NRD164033GB 17 Feb	195'
Tee 2x5/8 or 2x1		
Tee 4x5/8 or 4x1	298595	1
Tee 6x5/8 or 6x1		
EFV 5/8 or 1"	13171	1
2 5, 10 or 12 # Meter Bar		
Cplg 5/8 or 1 or 2"	2	
Bracket - post - Foundn.		
Split Bolt	2	
Riser 5/8 or 1"		
5/8 or 1" ELL		
Cap 5/8 or 1"		
PE Tee 5/8 or 1"		
PE Reducer 5/8x1"		1
Scrap Pipe		5
Scrap wire		5
wire		198
Carsonite	Anode 3#	
# of Heaters	Restoration Y N	

Meter	
Locked ☐	Unlocked ☒ SE
Size 275	Location Left Rear
MFG Sensus	Reading 0000
New Meter # 18171123	
Reg. Type/Press. 2#	5# 10# 12#
Old Meter#	
Old Meter Reading:	

Does Winter Construction Apply? Y ☐ N ☐

Condition of Existing Pipe		
Outside	Inside	Coating
Good ☐	☐	☐
Fair ☐	☐	☐
Bad ☐	☐	☐
Anode #	MV Reading	

Existing Main	
Size 4"	Pressure Type/Mfr Dura Line
Lot #	Cover 36" Location 42' N. G
New Service / Main	
Size 1"	Lot # NRD164033GB 17 Feb
Poly Mfr Dura Line	Nature of Soil clay
Tap Size 1/2	Cover 36" Completion Date 9/20/13
Foreman ID T. Schuchman	Welder/Fuser ID T. Schuchman
Pressure Test	
Test With: Air / Nitrogen	Duration 15 min Emp ID T. Schuchman
Date Tested 9/20/13	PSI 150 Soap Test Final Tie-in? Y ☒ N ☐
Filled out by Mapping Dept.	
Mapped in System Maps	Date
Mapped in GIS	Date
Entry Person	Date
GSOC Polygon Available	Yes No

Description	Install Footage
Directional Bore	
Pneumatic Bore	45
Backhoe	15
Inserting	
Trench	
Plow	129
Hand Digging	6'
Splitting	
Joint Trench	
Gopher Pipe	
Cust. Perf. Loc.	