


GAS ASBUILT

Address: 107 Cable Rd. Swanville 132601929
 Property: Lot 017 Block 002 city
 WO: 13 SC - SW - 81 - SWS - 5026 -

9-19 Flagged 9/6 CS.
 45 White Flag

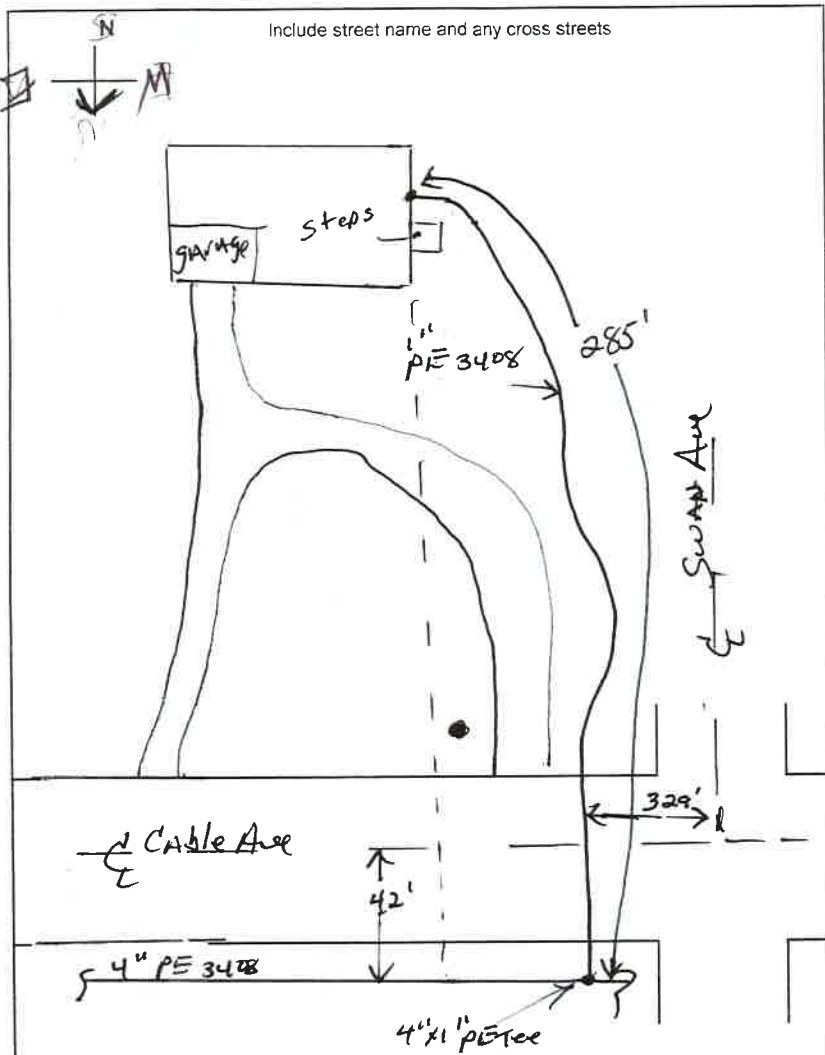

Remarks:

Material List	Lot #	Qty
Pipe 5/8" or 1"	NRD 16 Y 103 368 Feb 17	285'
Tee 2x5/8 or 2x1		
Tee 4x5/8 or 4x1	298595	1
Tee 6x5/8 or 6x1		
EFV 5/8 or 1"	13171	1
2, 5, 10 or 12 # Meter Ba		
Cplg 5/8 or 3/4 or 2"	2	
Split Bolt	2	
5/8 or 1" ELL		
PE Tee 5/8 or 1"		
PE Reducer 5/8x1"		1
Scrap pipe		7
Scrap wire		7
Wire		288
Carsonite	Anode 3#	
# of Heaters	Restoration	N

Meter	
Locked ☐	Unlocked ☒
Size <u>275</u>	Location <u>Right</u>
MFG <u>Sensus</u>	Reading <u>0000</u>
New Meter # <u>1817115</u>	
Reg. Type/Press. <u>2#</u>	5# 10# 12#
Old Meter#	
Old Meter Reading:	

Does Winter Construction Apply? Y ☐ N ☐

Condition of Existing Pipe		
Outside	Inside	Coating
Good ☐	☐	☐
Fair ☐	☐	☐
Bad ☐	☐	☐
Anode #	MV Reading	

Existing Main		
Size <u>4"</u>	Pressure	Type/Mfr <u>Dura Line</u>
Lot #	Cover <u>36</u>	Location <u>42' N. C.</u>

New Service / Main		
Size <u>1"</u>	Lot # <u>NRD 16 Y 103 368 Feb 17</u>	
Poly Mfr <u>Dura Line</u>	Nature of Soil <u>C / LAY</u>	
Tap Size <u>1/2"</u>	Cover <u>36</u>	Completion Date <u>9/20/13</u>
Foreman ID <u>T. Schwanhaar</u>	Welder/Fuser ID <u>T. Schwanhaar</u>	

Pressure Test		
Test With: <u>Air / Nitrogen</u>	Duration <u>30 min</u>	Emp ID <u>T. Schwanhaar</u>
Date Tested <u>9/20/13</u>	PSI <u>150</u>	Soap Test Final Tie-in? Y ☒ N ☐

Filled out by Mapping Dept.		
Mapped in System Maps	Date	
Mapped in GIS	Date	
Entry Person	Date	
GSOC Polygon Available	Yes	No

Description	Install Footage
Directional Bore	
Pneumatic Bore	45
Backhoe	20
Inserting	
Trench	
Plow	214
Hand Digging	6
Splitting	
Joint Trench	
Gopher Pipe	
Cust. Perf. Loc.	