

GAS ASBUILT

STREET ADDRESS

1498 Cable Rd

Mailing Address


Swanville, Mn

W.O. #

13-SC-SW-81-SWS-5038

CITY/Twp

CITY/Twp

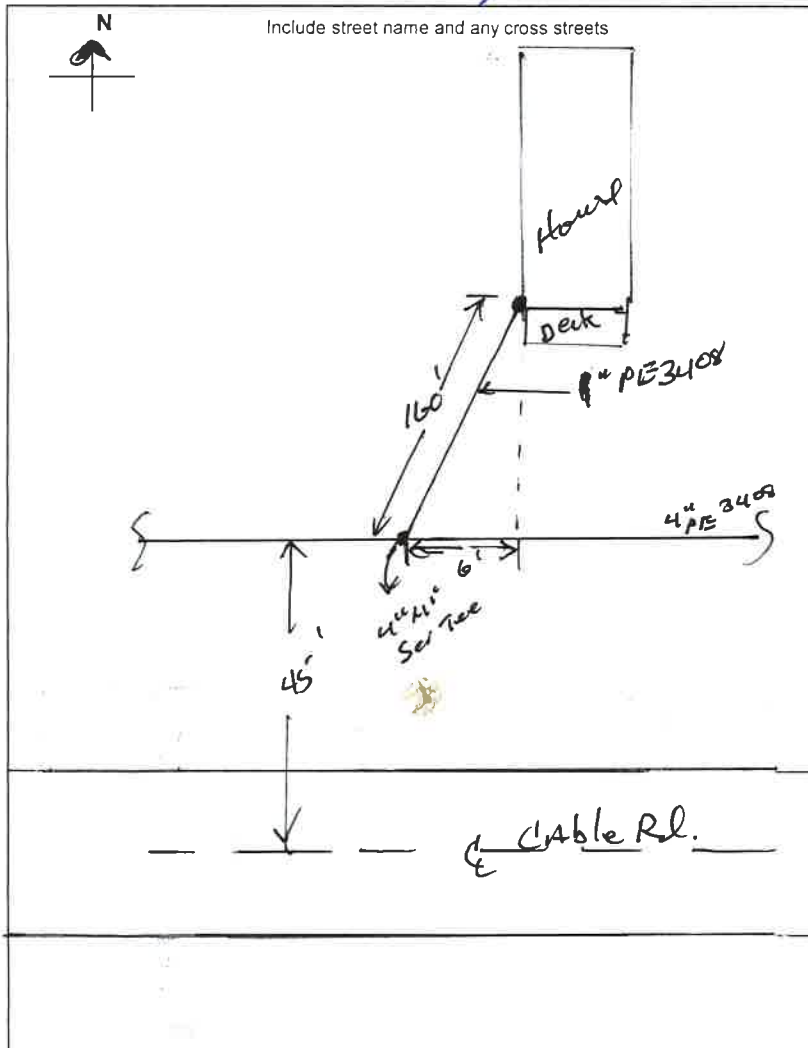

Remarks:

Material List	Lot #	Qty
Pipe 5/8" or 1"	NRD 16403 36B 17 Feb	160
Tee 2x5/8 or 2x1		
Tee 4x5/8 or 4x1	298595	1
Tee 6x5/8 or 6x1		
EFV 5/8 or 1"	13171	1
2, 5, 10 or 12 # Meter Bar		
Cplg 5/8 or 1 or 2"	1	
Bracket - post - Foundtn.		
Split Bolt	2	1
5/8 or 1" ELL		
PE Tee 5/8 or 1"		
PE Reducer 5/8x1"		
Scrap pipe		10
Scrap wire		10
Carsonite	Anode 3#	
# of Heaters	Restoration Y N	

Meter

Locked ☐ Unlocked ☒

Size 275 Location Rear right

MFG Sensus Reading 0000

New Meter # _____

Reg. Type/Press 2# 5# 10# 12#

Old Meter# _____

Old Meter Reading: _____

Does Winter Construction Apply? Y ☐ N ☐

Condition of Existing Pipe

	Outside	Inside	Coating
Good	☐	☐	☐
Fair	☐	☐	☐
Bad	☐	☐	☐

Anode # _____ MV Reading _____

Existing Main

Size 4 Pressure _____ Type/Mfr PE 3408 - Dura Line

Lot # _____ Cover 38" Location _____

New Service / Main

Size 1" Lot # NRD 16403 36B 17 Feb

Poly Mfr Dura Line Nature of Soil sandy clay

Tap Size 1/2 Cover 38" Completion Date 9/23/13

Foreman ID T. Schuchman Welder/Fuser ID T. Schuchman

Pressure Test

Test With: Air ☒ Nitrogen ☐ Duration 20 min Emp ID T. Schuchman

Date Tested 9/23/13 PSI 150 Soap Test Final Tie-in? Y ☒ N ☐

Filled out by Mapping Dept.

Mapped in System Maps _____ Date _____

Mapped in GIS _____ Date _____

Entry Person _____ Date _____

GSOC Polygon Available Yes ☐ No ☐

Description	Install Footage
Directional Bore	
Pneumatic Bore	
Backhoe	70'
Inserting	
Trench	10'
Plow	140'
Hand Digging	
Splitting	
Joint Trench	
Gopher Pipe	
Cust. Perf. Loc.	