

GAS ASBUILT


Address: 1533 Cable Rd. Swanville 132602118

Property: 128N 31W 7

WO: 13 SC - SW - 81 - SWS - 5029 - 9-19 LIS

White Flag

Flagged 9/5 C.S.

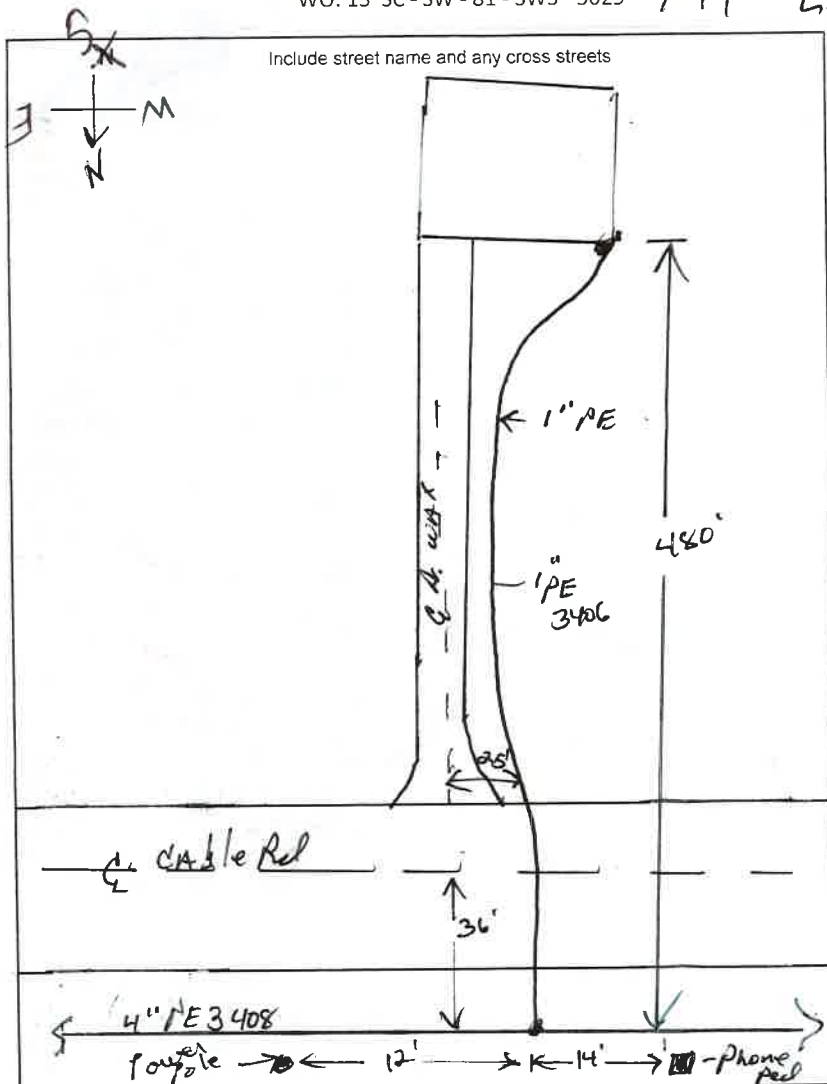

Remarks:

Material List	Lot #	Qty
Pipe 5/8" or 1"	NRD16Y033GB17	480'
Tee 2x5/8 or 2x1		
Tee 4x5/8 or 4x2	298595	1
Tee 6x5/8 or 6x1		
EFV 5/8 or 1"	13171	1
5, 10 or 12 # Meter Bar		
Cplg 5/8 or 1 or 2" - 4	Bracket - post - Foundtn.	
Split Bolt 2	Riser 5/8 c	1
5/8 or 1" ELL	Cap 5/8 or 1"	
PE Tee 5/8 or 1"	PE Reducer 5/8x1"	1
Scrap pipe		10'
Scrap wire		10'
		482'
Carsonite	Anode 3#	
# of Heaters	Restoration Y N	

Meter			
Locked	☐	Unlocked	☒ NW
Size	275	Location	Right Front
MFG	Sensus	Reading	0000
New Meter #	18171152		
Reg. Type/Press.	2#	5#	10# 12#
Old Meter#			
Old Meter Reading			

Does Winter Construction Apply? Y ☐ N ☐

Condition of Existing Pipe		
Outside	Inside	Coating
Good ☐	☐	☐
Fair ☐	☐	☐
Bad ☐	☐	☐
Anode #		MV Reading

Existing Main	
Size 4"	Pressure Type/Mfr 3408 - Dura Line
Lot #	Cover 38" Location
New Service / Main	
Size 1"	Lot #
Poly Mfr Dura Line	Nature of Soil sand/clay
Tap Size	Cover Completion Date 9/23/13
Foreman ID T. Schwanhauser	Welder/Fuser ID T. Schwanhauser
Pressure Test	
Test With: Air / Nitrogen	Duration 30 Emp ID T. Schwanhauser
Date Tested 9/23/13	PSI 150 Soap Test Final Tie-in? Y ☒ N ☐
Filled out by Mapping Dept.	
Mapped in System Maps	Date
Mapped in GIS	Date
Entry Person	Date
GSOC Polygon Available	Yes No

Description	Install Footage
Directional Bore	
Pneumatic Bore	46'
Backhoe	20
Inserting	
Trench	
Plow	404'
Hand Digging	10
Splitting	
Joint Trench	
Gopher Pipe	
Cust. Perf. Loc.	

updated 4/26/13