


GAS ASBUILT

Address: 1541 Cable Rd. Swanville 132602129

Property: 128N 31W 7

WO: 13 SC - SW - 81 - SWS - 5075 - 9-19 L/S

White Flag
Flagged 9/5 C.S.

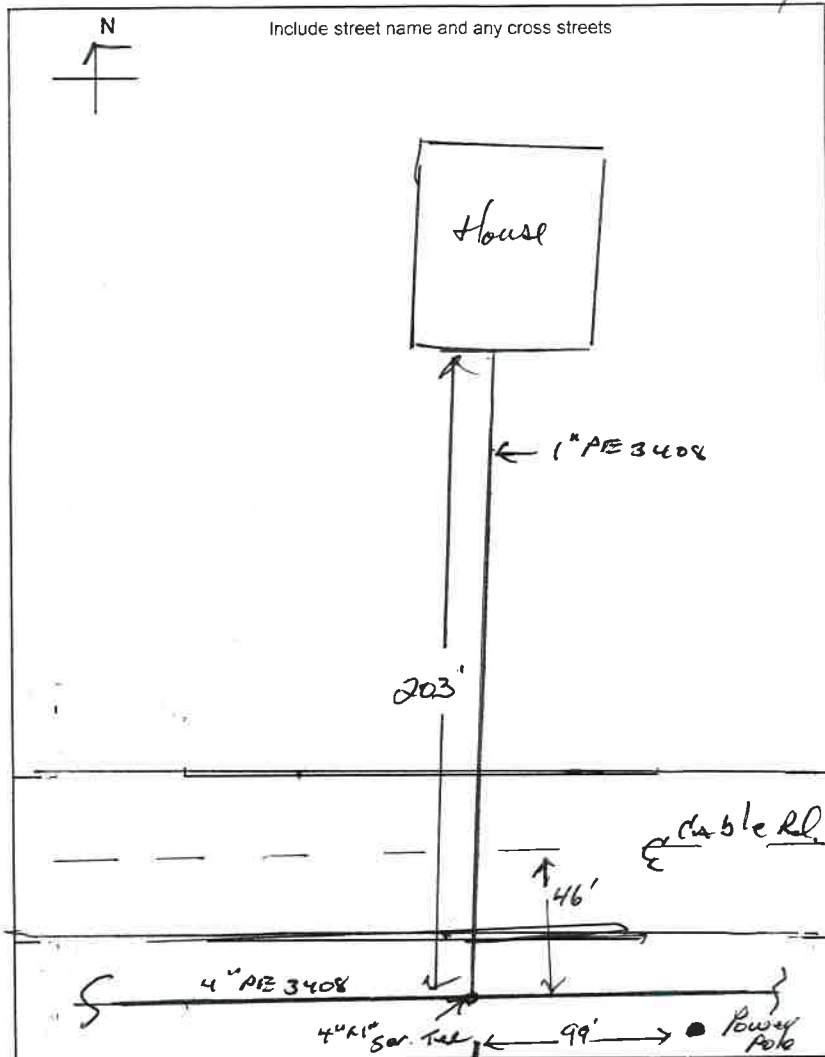

Remarks:

Material List	Lot #	Qty
Pipe 5/8" or 1"	NRD 1640336816	203
Tee 2x5/8 or 2x1		
Tee 4x5/8 or 4x1	298595	1
Tee 6x5/8 or 6x1		
EFV 5/8 or 1"	13171	1
5, 10 or 12 # Meter Bar		
Cplg 5/8 or 1 or 2"	Bracket - post - Foundn.	
Split Bolt 2	Riser 5/8 or 1"	1
5/8 or 1" ELL	Cap 5/8 or 1"	
PE Tee 5/8 or 1"	PE Reducer 5/8x1"	1
Scrap pipe		20'
Scrap wire		10'
Wire		205'
Carsonite	Anode 3#	
# of Heaters	Restoration Y N	

Meter	
Locked ☐	Unlocked ☒
Size 275	Location Front
MFG Sensus	Reading 0000
New Meter # 18171116	
Reg. Type/Press. 2#	5# 10# 12#
Old Meter#	
Old Meter Reading:	
Does Winter Construction Apply?	Y ☐ N ☐

Condition of Existing Pipe		
Outside	Inside	Coating
Good ☐	☐	☐
Fair ☐	☐	☐
Bad ☐	☐	☐
Anode #	MV Reading	

Existing Main	
Size 4"	Pressure Type/Mfr 3408 Dura Line
Lot #	Cover Location

New Service / Main	
Size 1"	Lot # NRD 1640336817 Feb
Poly Mfr Dura Line	Nature of Soil clay
Tap Size 1/2"	Cover 44" Completion Date 9/24/13
Foreman ID T. Schwabauer	Welder/Fuser ID T. Schwabauer

Pressure Test	
Test With: Air / Nitrogen	Duration 30 Emp ID T. Schwabauer
Date Tested 9/24/13	PSI 150 Soap Test Final Tie-in? Y ☒ N ☐

Filled out by Mapping Dept.	
Mapped in System Maps	Date
Mapped in GIS	Date
Entry Person	Date
GSOC Polygon Available	Yes No

Description	Install Footage
Directional Bore	
Pneumatic Bore	46'
Backhoe	20
Inserting	
Trench	
Plow	157
Hand Digging	7
Splitting	
Joint Trench	
Gopher Pipe	
Cust. Perf. Loc.	