


GAS ASBUILT

Address: 1732 Cable Rd. Swanville 132602246
 Property: 128N 31W 6
 WO: 13 SC - SW - 81 - SWS - 5059 - 9-19 S/S

White Flag
 Flagged 9/5 c.s.

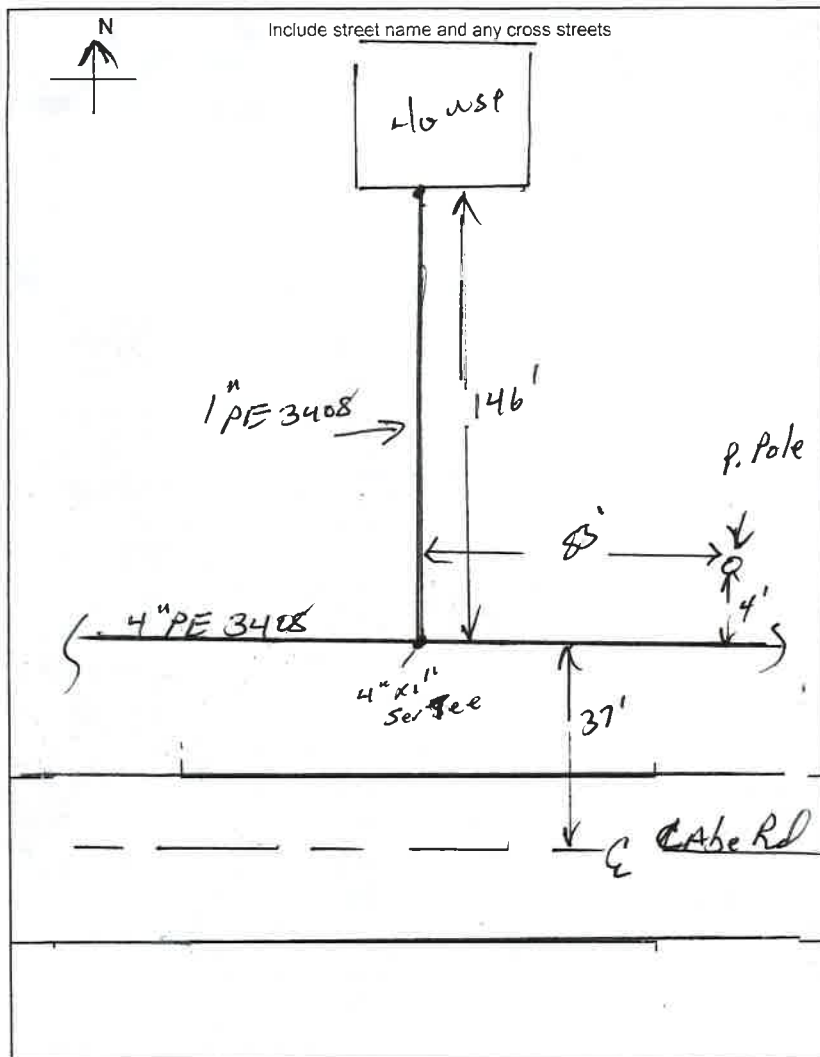

Remarks: _____

Material List	Lot #	Qty
Pipe 5/8" or 1"	MA01646336816	146'
Tee 2x5/8 or 2x1		
Tee 4x5/8 or 4x1	298595	1
Tee 6x5/8 or 6x1		
EFV 5/8 or 1"	13171	1
2, 5, 10 or 12 # Meter Bar		
Cplg 5/8 or 1" or 2"	1	
Split Bolt	2	
5/8 or 1" ELL		
PE Tee 5/8 or 1"		
Scrap Pipe		10'
Scrap wire		10'
Wire		148'
Carsonite	Anode 3#	
# of Heaters	Restoration Y N	

Meter	
Locked ☐	Unlocked ☒
Size <u>275</u>	Location <u>Front</u>
MFG <u>Sensus</u>	Reading <u>0060</u>
New Meter # <u>18171124</u>	
Reg. Type/Press.	<u>2#</u> <u>5#</u> <u>10#</u> <u>12#</u>
Old Meter# _____	
Old Meter Reading: _____	

Does Winter Construction Apply? Y ☐ N ☒

Condition of Existing Pipe		
Outside	Inside	Coating
Good ☐	☐	☐
Fair ☐	☐	☐
Bad ☐	☐	☐
Anode # _____	MV Reading _____	

Existing Main	
Size <u>4"</u>	Pressure _____ Type/Mfr <u>3408 - Alum - Line</u>
Lot # _____	Cover <u>38"</u> Location _____
New Service / Main	
Size <u>1"</u>	Lot # <u>PE 3408, Dura Line</u>
Poly Mfr <u>Dura Line</u>	Nature of Soil <u>clay</u>
Tap Size <u>1/2</u>	Cover <u>38"</u> Completion Date <u>9/23/13</u>
Foreman ID <u>T. Schuchman</u>	Welder/Fuser ID <u>T. Schuchman</u>
Pressure Test	
Test With: <u>Air</u>	Duration <u>30</u> Emp ID _____
Date Tested <u>9/23/13</u>	PSI <u>150</u> Soap Test Final Tie-in? Y ☒ N ☐
Filled out by Mapping Dept.	
Mapped in System Maps _____	Date _____
Mapped in GIS _____	Date _____
Entry Person _____	Date _____
GSOC Polygon Available	Yes ☐ No ☐

Description	Install Footage
Directional Bore	
Pneumatic Bore	
Backhoe	10
Inserting	
Trench	
Plow	129
Hand Digging	7
Splitting	
Joint Trench	
Gopher Pipe	
Cust. Perf. Loc.	