


GAS ASBUILT

Address: 2240 Cable Rd. Swanville
 Property: 128N 31W 05
 WO: 13- SC - SW - 81 - SWS - 4948 -

White Flag

Flagged 9/5 C.S.

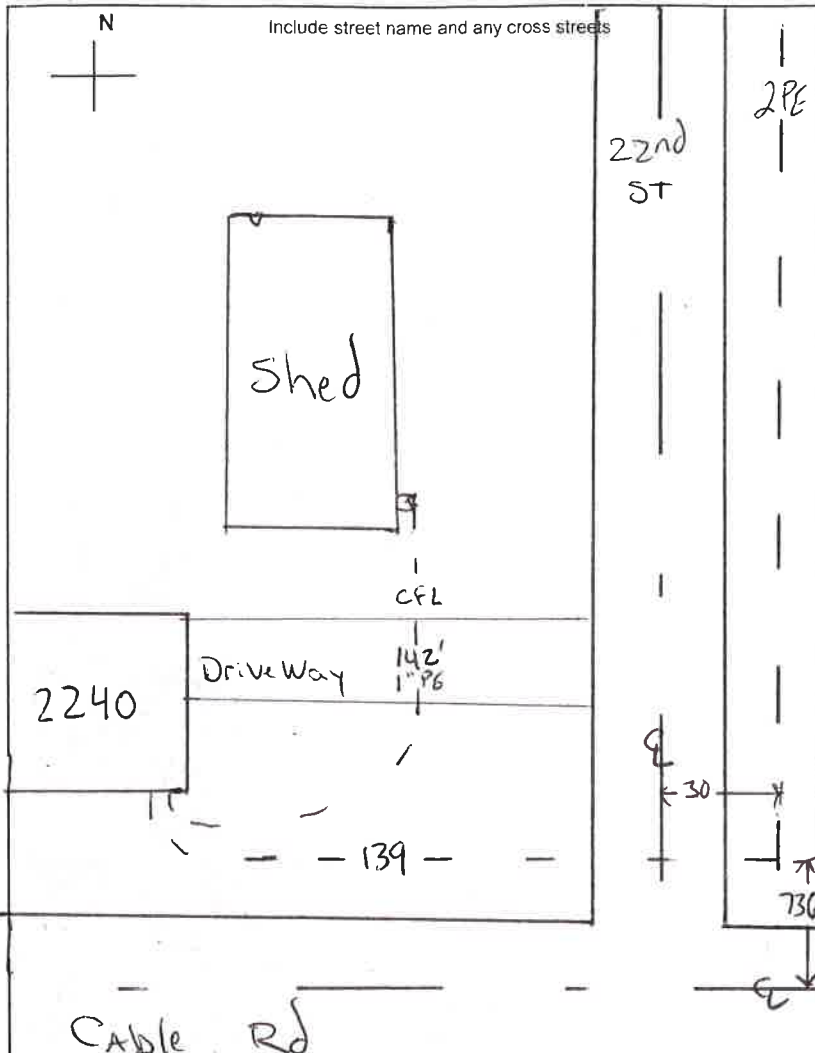

Remarks:

1" PE CEEASTMD2513NRD
 CFL Pnts - 1" Pipe 142' (2) 1" eplgs (2) 1" Risers
 142 wire

Material List	Lot #	Qty
Pipe 5/8" or 1"	See Remarks	
Tee 2x5/8 or 2x1	298595	1
Tee 4x5/8 or 4x1		
Tee 6x5/8 or 6x1		
EFV 5/8 or 1"	13171	1
2, 5, 10 or 12 # Meter Bar		1
Cplg 5/8 or 1 or 2" (1)	Bracket - post Foundn.	1
Split Bolt (1)	Riser 5/8 or 1"	1
5/8 or 1" ELL	Cap 5/8 or 1"	
PE Tee 5/8 or 1"	PE Reducer 5/8x1"	1
Carsonite	Anode 3#	
# of Heaters	Restoration Y N	

Meter	
Locked ☐	Unlocked ☒
Size 275	Location South
MFG Sensus	Reading 0000
New Meter # 18032952	
Reg. Type/Press. (2#)	5# 10# 12#
Old Meter#	
Old Meter Reading:	

Does Winter Construction Apply? Y ☐ N ☒

Condition of Existing Pipe		
Outside	Inside	Coating
Good ☐	☐	☐
Fair ☐	☐	☐
Bad ☐	☐	☐
Anode #	MV Reading	

Existing Main	
Size 2	Pressure 100 Type/Mfr Dura-Line
Lot #	Cover 36 Location
New Service / Main	
Size 1"	Lot # See Remarks
Poly Mfr Dura-Line	Nature of Soil Gravel
Tap Size	Cover 30 Completion Date 10-4-13
Foreman ID 5578	Welder/Fuser ID 7945
Pressure Test	
Test With: Air * Nitrogen	Duration 30 Emp ID 7945
Date Tested 10-4-13	PSI 152 Soap Test Final Tie-in? Y ☒ N ☐
Filled out by Mapping Dept.	
Mapped in System Maps	Date
Mapped in GIS	Date
Entry Person	Date
GSOC Polygon Available	Yes No

Description	Install Footage
Directional Bore	
Pneumatic Bore	
Backhoe	
Inserting	
Trench	
Plow	139
Hand Digging	
Splitting	
Joint Trench	
Gopher Pipe	
Cust. Perf. Loc.	