

GAS ASBUILT

STREET ADDRESS

Mailing Address

2244 Cable Rd.

R128N/ 32W/ sect 5

(House) 132690578

7-30-13

8:15

W.O. #


CITY/Twp

CITY/Twp

13-SC-SW-81-SuS-Woodland

White Flag

5144

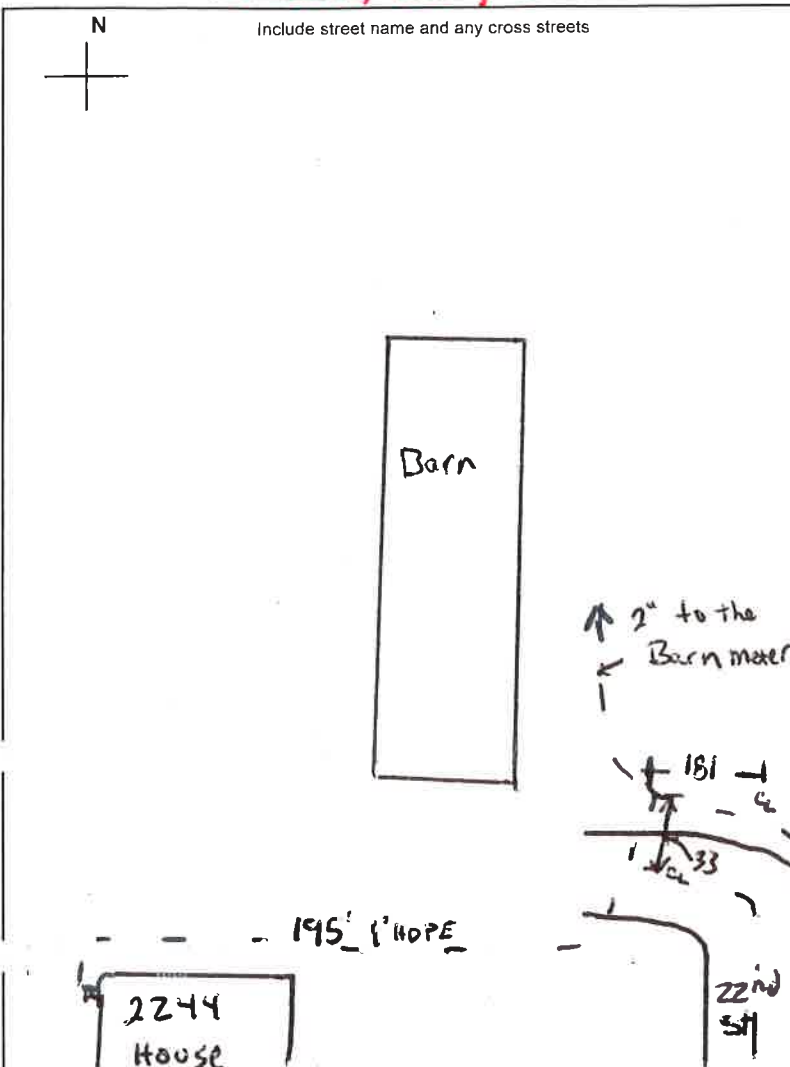

Pipe & Fitting Type ☒ High D ☐ Medium D

Material List	Lot #	Qty
Pipe 5/8" o 1"	See Remarks	195
Tee 2x5/8 o 2x1	298595	1
Tee 4x5/8 or 4x1		
Tee 6x5/8 or 6x1		
EFV 5/8 o 1"	13171	1
2, 5, 10 or 12 # Meter Bar		1
Cplg 5/8 or 1 or 2"	Bracket post - Foundn.	1
Split Bolt	Riser 5/8 or	1
5/8 or 1" ELL	Cap 5/8 or 1"	1
PE Tee 5/8 or 1"	PE Reducer 5/8x1"	1

Carsonite Anode 3#
of Heaters Restoration Y N

Meter

Locked ☐ Unlocked ☒

Size 275 Location West

MFG Sensus Reading 0000

New Meter # 18033012

Reg. Type/Press. 2# 5# 10# 12#

Old Meter#

Old Meter Reading:

Does Winter Construction Apply? Y N

Remarks:
HOPE CEE ASTM D2513 NRD 16 Y0336 A 18 Feb 13
coil # 000022

Existing Main

Size 2 Pressure 100 Type/Mfr Dura-Line
Lot # Cover 36 Location

New Service / Main

Size 1 Lot # See Remarks
Poly Mfr Dura-Line Nature of Soil Sandy
Tap Size Cover 30 Completion Date 10-1-13
Foreman ID 5578 Welder/Fuser ID 7945

Pressure Test

Test With: Air X Nitrogen Duration 30 Emp ID 7945
Date Tested 10-1-13 PSI 152 Soap Test Final Tie-in? Y X N

Filled out by Mapping Dept.

Mapped in System Maps Date
Mapped in GIS Date
Entry Person Date
GSOC Polygon Available Yes No

Condition of Existing Pipe

Outside	Inside	Coating
Good ☐	☐	☐
Fair ☐	☐	☐
Bad ☐	☐	☐

Anode # MV Reading

Description	Install Footage
Directional Bore	
Pneumatic Bore	
Backhoe	
Inserting	
Trench	
Plow	195
Hand Digging	
Joint Trench	
Gopher Pipe	
Cust. Perf. Loc.	

Permit Required Y N off of 22nd ave.
updated 8/12/2013