


GAS ASBUILT

Address: 2244 Cable Rd. Swanville - 22nd Av.?

Property: 128N 31W 5

WO: 13 SC - SW - 81 - SWS - 0 - Defoe, Woodland

White Flag

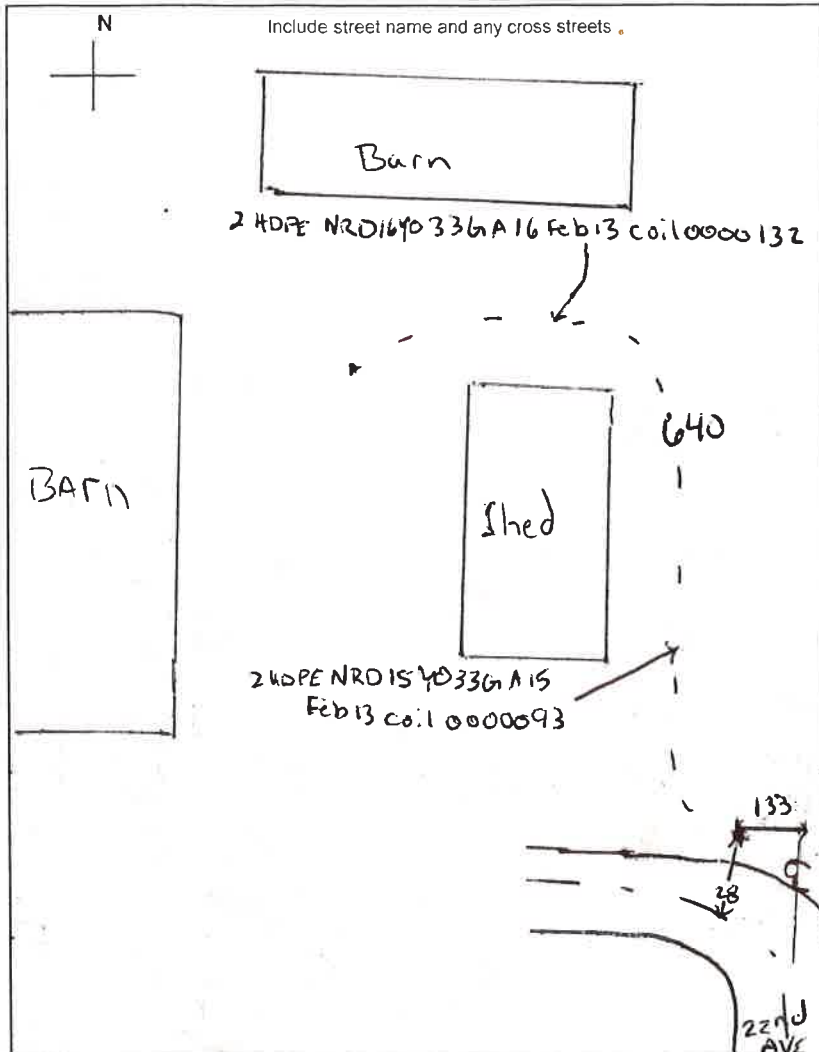

Remarks: GmG will set the meter

Material List	Lot #	Qty
Pipe 5/8" or 1"		
Tee 2x5/8 or 2x1		
Tee 4x5/8 or 4x1		
Tee 6x5/8 or 6x1		
EFV 5/8 or 1"		
2, 5, 10 or 12 # Meter Bar		
Cplg 5/8 or 1 or 2"	Bracket - post - Foundtn.	
Split Bolt	Riser 5/8 or 1"	
5/8 or 1" ELL	Cap 5/8 or 1"	
PE Tee 5/8 or 1"	PE Reducer 5/8x1"	
2" HDPE	See Asbuilt	640
2 Riser		1
Carsonite	Anode 3#	
# of Heaters	Restoration Y N	

Meter	
Locked ☐	Unlocked ☐
Size <u>N₂</u>	Location
MFG	Reading
New Meter #	
Reg. Type/Press.	2# 5# 10# 12#
Old Meter#	
Old Meter Reading:	

Does Winter Construction Apply? Y ☐ N ☐

Condition of Existing Pipe		
Outside	Inside	Coating
Good ☐	☐	☐
Fair ☐	☐	☐
Bad ☐	☐	☐
Anode #	MV Reading	

Existing Main	
Size <u>2</u>	Pressure <u>100</u> Type/Mfr
Lot #	Cover <u>36</u> Location
New Service / Main	
Size <u>2</u>	Lot # <u>See Asbuilt</u>
Poly Mfr	Nature of Soil <u>Sandy</u>
Tap Size	Cover <u>30</u> Completion Date <u>8-17-13</u>
Foreman ID <u>5578</u>	Welder/Fuser ID <u>7945</u>
Pressure Test	
Test With: <u>Air</u> / <u>Nitrogen</u>	Duration <u>30</u> Emp ID <u>7945</u>
Date Tested <u>8-17-13</u> PSI <u>152</u>	Soap Test Final Tie-in? Y ☒ N ☐
Filled out by Mapping Dept.	
Mapped in System Maps	Date
Mapped in GIS	Date
Entry Person	Date
GSOC Polygon Available	Yes No

Description	Install Footage
Directional Bore	
Pneumatic Bore	
Backhoe	
Inserting	
Trench	
Plow	640
Hand Digging	
Splitting	
Joint Trench	
Gopher Pipe	
Cust. Perf. Loc.	