


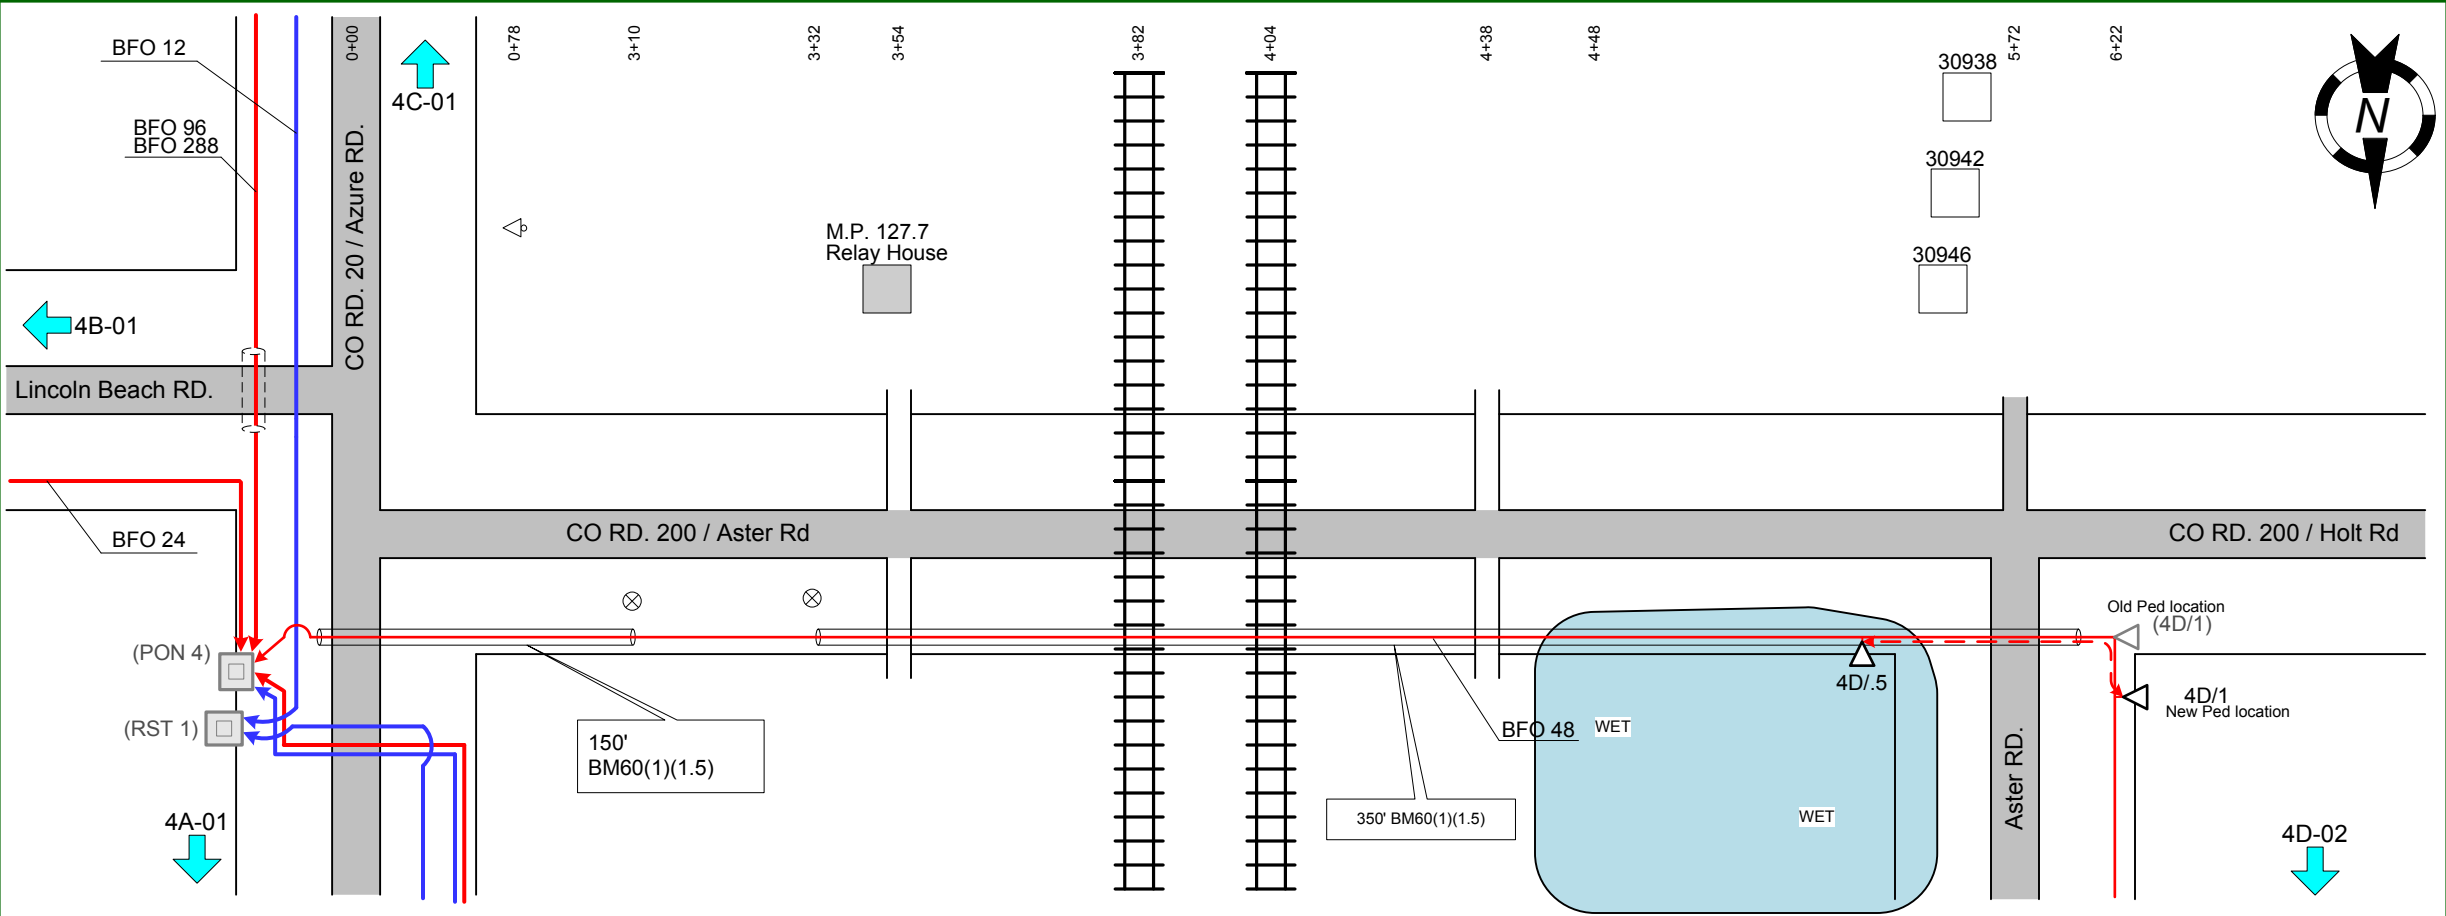

From	To	PType	Units	Feet	BA		BM		HO		W		Remarks
	4D/.5	BDO4(SG)			3	1	2(5/8)(8)	1	1	48	BFO 48	12	
	4D/.5						53	1					
4D/.5	4D/1	BDO4(SG)	UO 48	120	3	1	2(5/8)(8)	1	1	48	BFO 48	12	
	4D/1		UD(1x1-1.25)A	20			53	1					

**As Built**
Consolidated Telephone Company

Name: 2013 4D-01
WO: 2013 - Lincoln
Exch: Lincoln
Route: 4D
ROW: 50'
State: Minnesota
County: Morrison
Range: 31W
Twsp: 132N **Section:** 32
Township: Scandia Valley

Staked By: DME **Date:** 10/19/11
Revised By: RJB **Date:** 03/20/12
Revised By: JM **Date:**
Revised By: EMD **Date:** 10-14-13
As-Built By: MN **Date:** 10/15/12

Sheet No.	1	of	4
-----------	---	----	---