


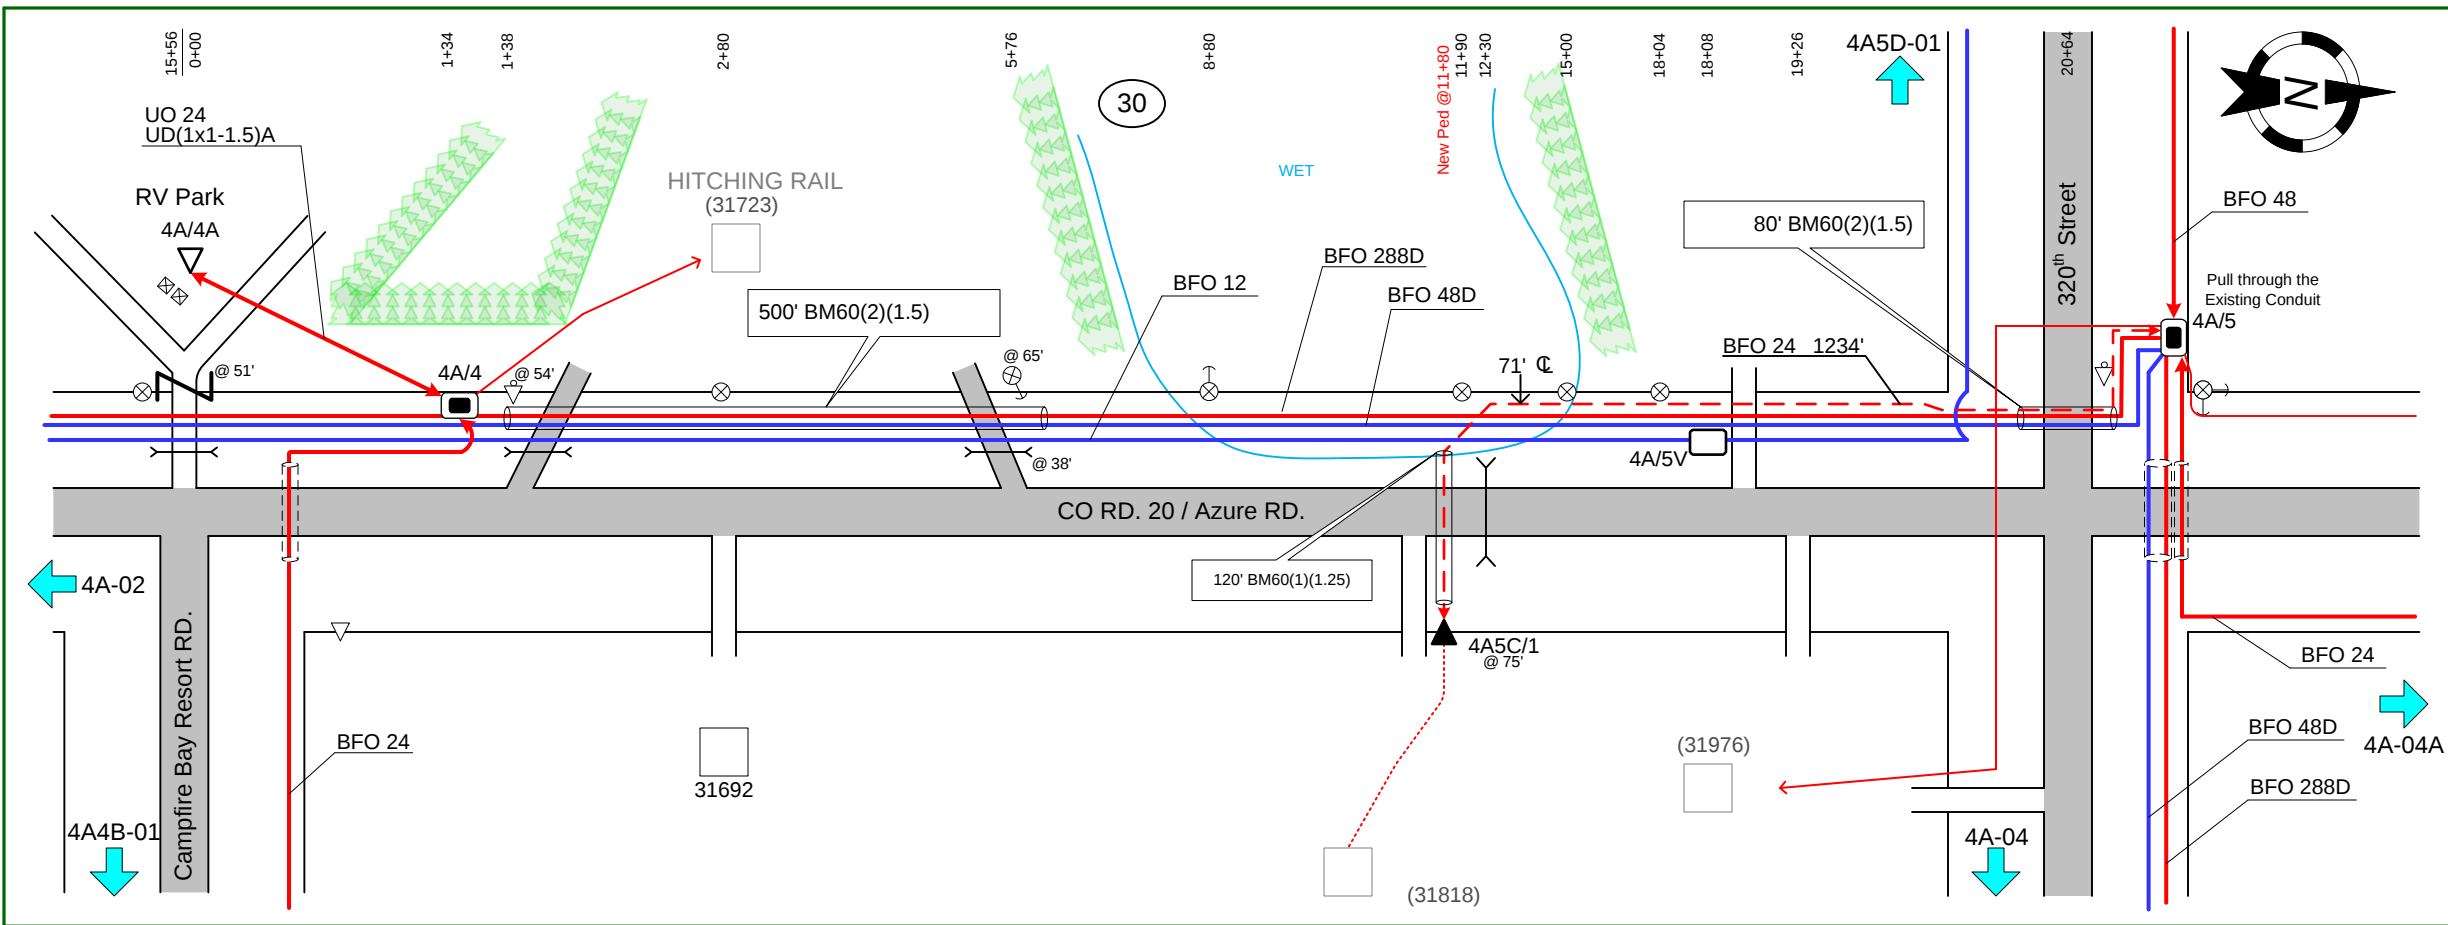

From	To	PType	Units	Feet	BA		BM		HO		Remarks
4A/5	4A5C/1	BDO5(AS)	BFO 24	1234	3	1	2(5/8)(8)	1	1	1	
	4A5C/1						60(1)(1.25)	120			
	4A5C/1						81	1			

**As Built**
Consolidated Telephone Company

Name: 4A-03
WO: 2015 CTC
Exch: Lincoln
Route: 4A
ROW: 50'
State: Minnesota
County: Morrison
Range: 31W
Twsp: 132N Section: 30
Township: Scandia Valley

Staked By: <u>RJB</u>	Date: <u>10/19/11</u>
Revised By: <u>RJB</u>	Date: <u>02/28/12</u>
Revised By: <u>JM</u>	Date: <u>9/11/12</u>
Revised By: _____	Date: _____
As-Built By: <u>MN</u>	Date: <u>9/20/12</u>

Sheet No.	3	of	10
-----------	---	----	----