DISTANCE FROM ℄ ROAD: SEE NOTATION	CTC	TWP 132 N	ROUTE: 3D3C
STAKED BY: FDB DATE: 8-4-11	PROJECT: MN537-2012	RNG 3D W	
REV. REV.	EXCHANGE: LINCOLN	SEC. 31	SHEET: 1 OF 4
AS BUILT BY: DATE:	TOWNSHIP: SCANDIA VALLEY	CO. MORRISON	SERVICE AREA: LINCOLN

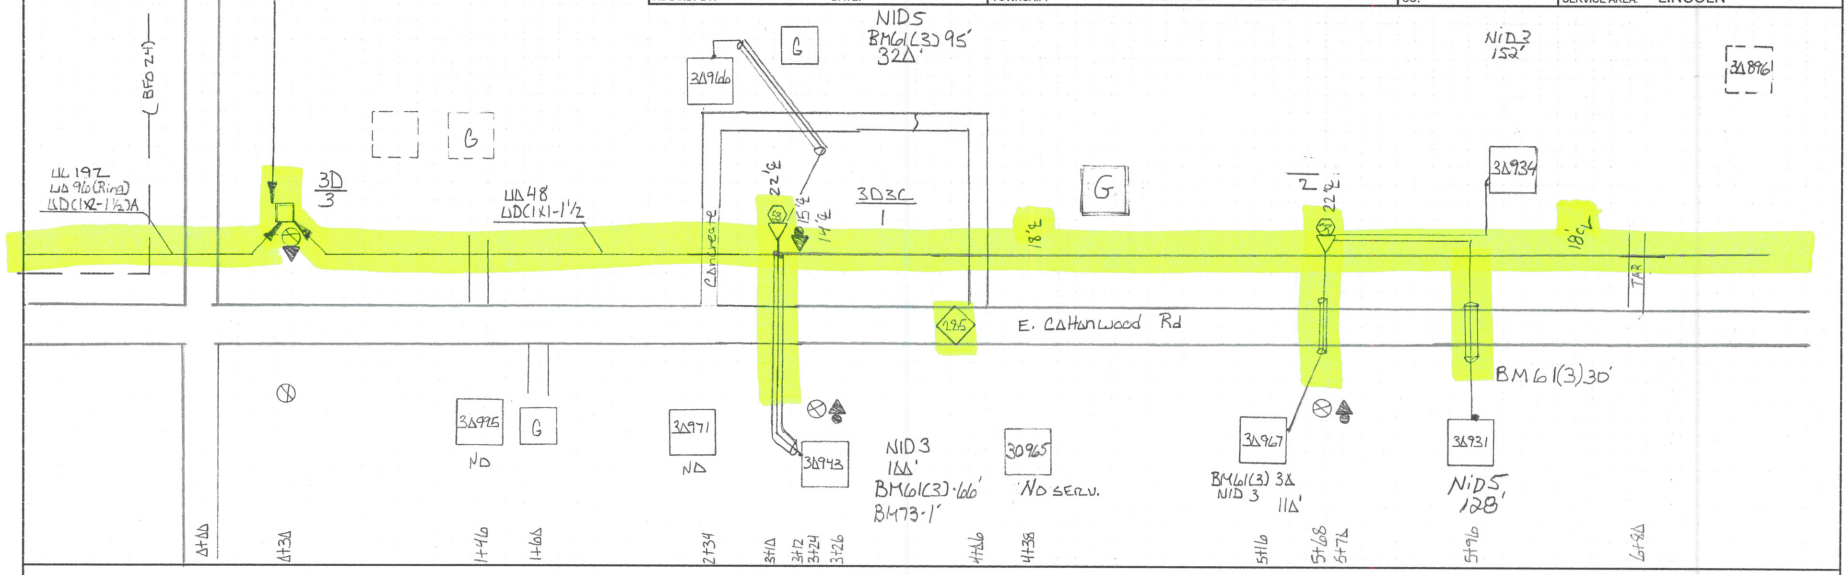

HOUSING NO.	BA	BDO			BFO				BH	BM						HBF		HO		NID		SUB NO.	SE		UD		UO		
				5 (66L)						2 (5/8X8)	53			61 (3)	73			1		3	5		B 4			(1X1-1½) A		48	
1				1						1	1			66	1			2		1		3D943	1DD			29L		44D	
														95							1	3D966	32D						
2				1						1	1			3D				3		1		3D967	11D			27D		39L	
														3D							1	3D931	128						
																				1		3D934	152						
				2						2	2			221	1			5		3	2		81D			56L		83L	

Prepared by CNS 612-564-1000

DISTANCE FROM ℄ ROAD: SEE NOTATION	CTC	TWP 132 N	ROUTE: 3D3C
STAKED BY: EDB DATE: 8-4-11	PROJECT: MN537-2012	RNG 30 W	
REV. REV.	EXCHANGE: LINCOLN	SEC. 31	SHEET: 2 OF 4
AS BUILT BY: DATE:	TOWNSHIP: SCANDIA VALLEY	CO. MORRISON	SERVICE AREA: LINCOLN

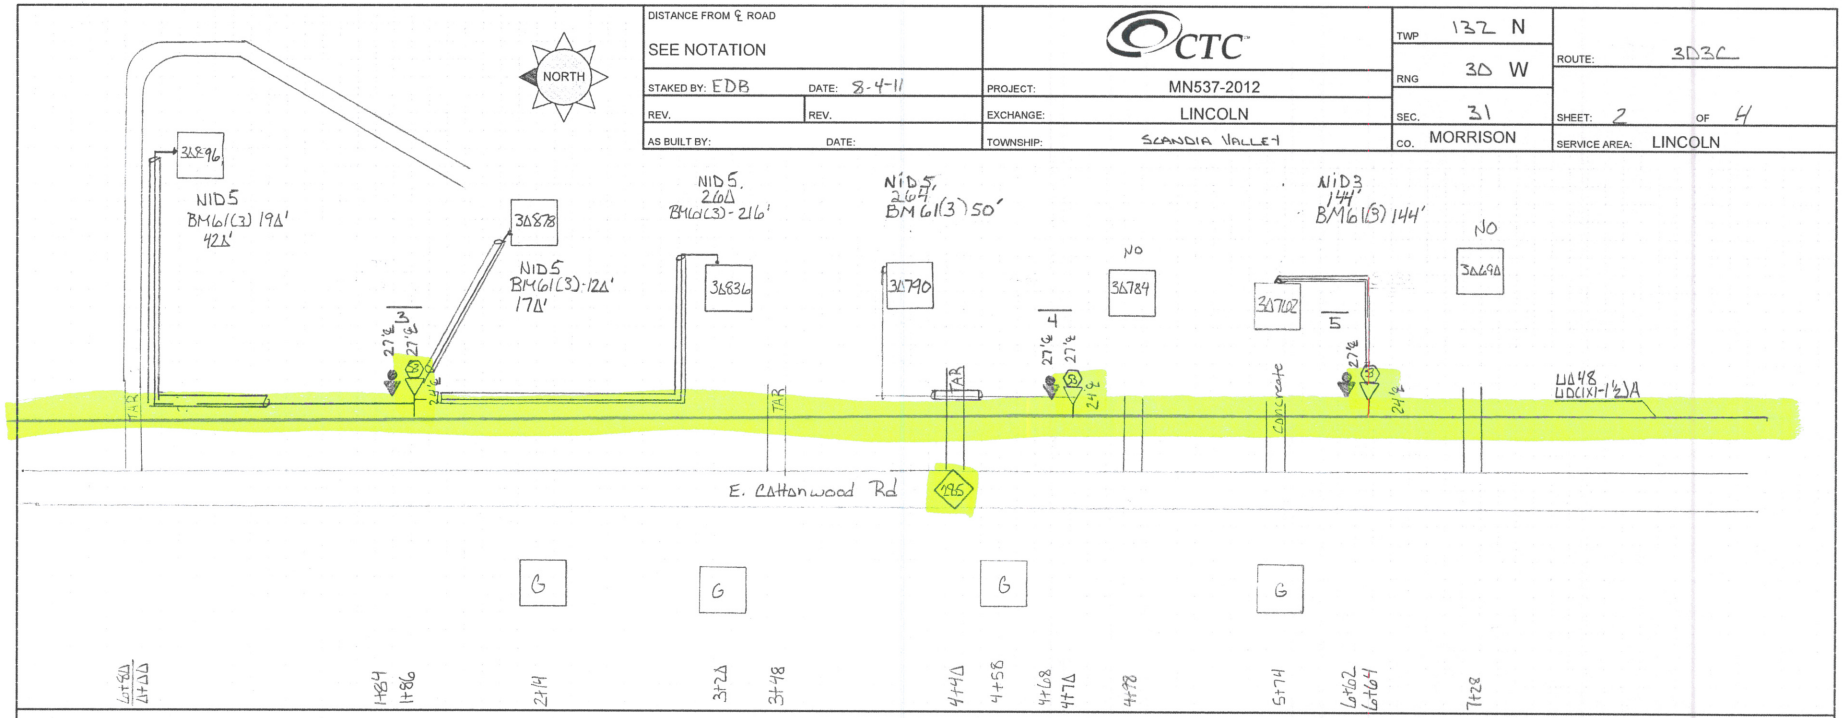

HOUSING NO.	BA	BDO			BFO				BH	BM					HBF		HO		NID		SUB NO.	SE		UD		UO		
				5 (5LC)						2 (5/8)(8)	53			61 (3)			1		3	5		B 4			(1x1-1½) A		48	
3				1						1	1			19Δ			3			1	30896	42Δ			31Δ		44Δ	
														12Δ						1	30878	17Δ						
														216						1	30836	26Δ						
4				1						1	1			5Δ			1			1	30790	264			29Δ		42Δ	
5				1						1	1			144			1		1		30762	144			20Δ		33Δ	
				3						3	3			72Δ			5		1	4		1258			81Z		120Z	

Provided by CNS

DISTANCE FROM ℄ ROAD: SEE NOTATION	CTC	TWP 132 N	ROUTE: 3D3C
STAKED BY: EDB DATE: 8-4-11	PROJECT: MN537-2012	RNG 30 W	SHEET: 3 OF 4
REV. REV.	EXCHANGE: LINCOLN	SEC. 31	
AS BUILT BY: DATE:	TOWNSHIP: SCANDIA VALLEY	CO. MORRISON	SERVICE AREA: LINCOLN

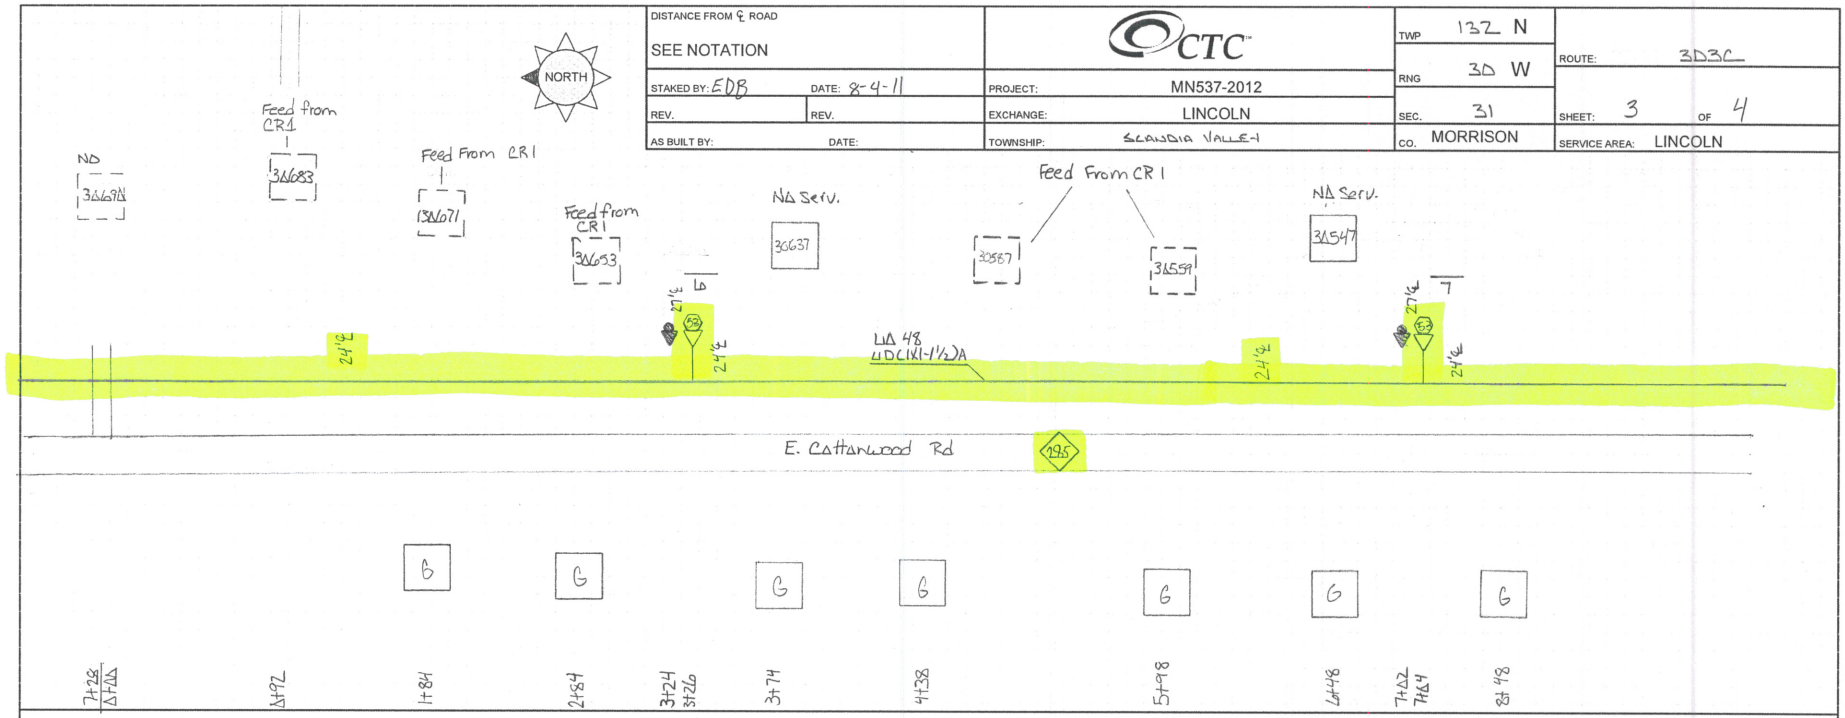

HOUSING NO.	BA	BDO	BFO	BH	BM	HBF	HO	NID	SUB NO.	SE	UD	UO
		5 (56C)			2 (518)(8) 53		1				(1x1-1½) A	48
6		1			1 1		LOOP				402	537
7		1			1 1		LOOP				378	508
		2			2 2						780	1040

Produced by CNS 218-564-3000

DISTANCE FROM ℄ ROAD		CTC	TWP 132 N	ROUTE: 3D3C
SEE NOTATION			RNG 30 W	
STAKED BY: EDB	DATE: 8-4-11	PROJECT: MN537-2012		
REV.	REV.	EXCHANGE: LINCOLN	SEC. 31	SHEET: 4 OF 4
AS BUILT BY:	DATE:	TOWNSHIP: SCANDIA VALLEY	CO. MORRISON	SERVICE AREA: LINCOLN

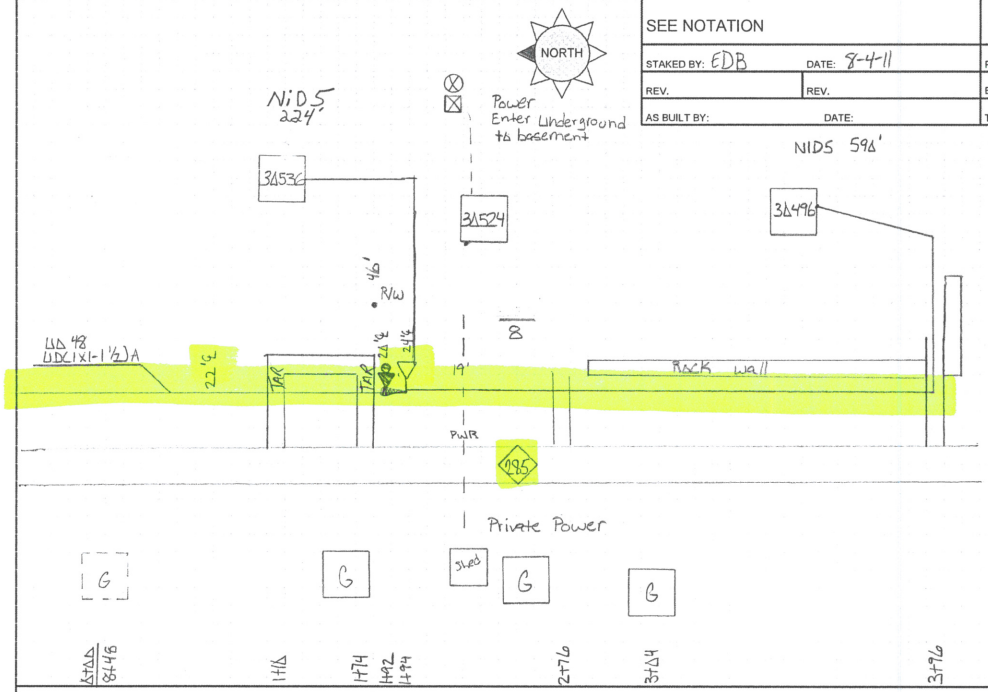

HOUSING NO.	BA	BDO	BFO	BH	BM	HBF	HO	NID	SUB NO.	SE	UD	UO
		5 (5/8C)			2 (5/8X8)		1	5		8 4	(1x1-1½) A	48
8		1			1		2	1	30536	224	348	428
								1	30496	590		
		1			1		2	2		814	348	428

PREPARED BY: CNS 218-564-3020

DISTANCE FROM ℄ ROAD: SEE NOTATION	CTC	TWP 132 N	ROUTE: 3C8A
STAKED BY: RE DATE: 8/11	PROJECT: MN537-2012	RNG 30 W	
REV. REV.	EXCHANGE: LINCOLN	SEC. 31	SHEET: 3 OF 3
AS BUILT BY: DATE:	TOWNSHIP: SLANDIA VALLEY	CO. MORRISON	SERVICE AREA: LINCOLN

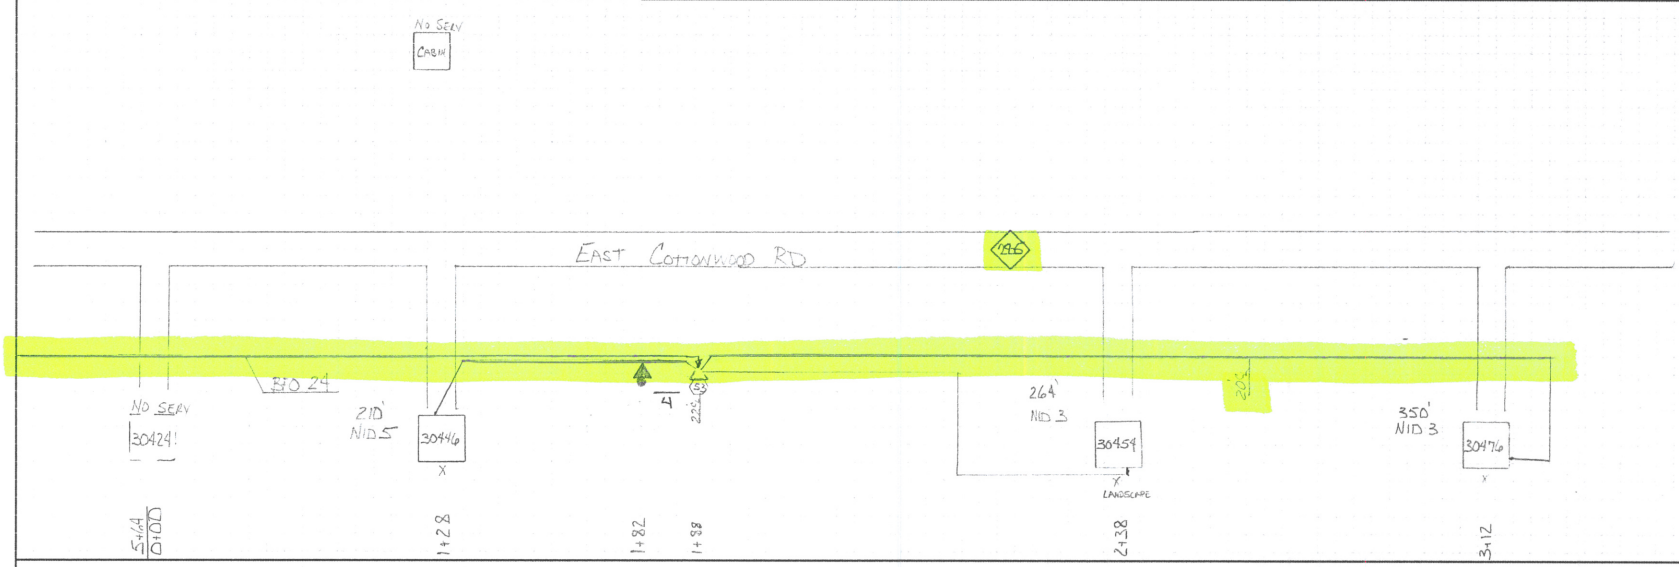

HOUSING NO.	BA	BDO			BFO				BH	BM						HBF		HO		NID		SUB NO.	SE		UD		UO		
			4 (S6)			24				2 (5/8X8)	53							1		3	5		B 4						
4			1			410				1	1							3			1	30446	210						
																				1		30454	264						
																				1		30476	350						
			1			410				1	1							3		2	1		824						

Prepared By CNS 276-564-3000

DISTANCE FROM ℄ ROAD: SEE NOTATION	CTC	TWP 132 N	ROUTE: 3C8A
STAKED BY: RE DATE: 8/11	PROJECT: MN537-2012	RNG 30 W	
REV. REV.	EXCHANGE: LINCOLN	SEC. 31	SHEET: 2 OF 3
AS BUILT BY: DATE:	TOWNSHIP: SCANDIA VALLEY	CO. MORRISON	SERVICE AREA: LINCOLN

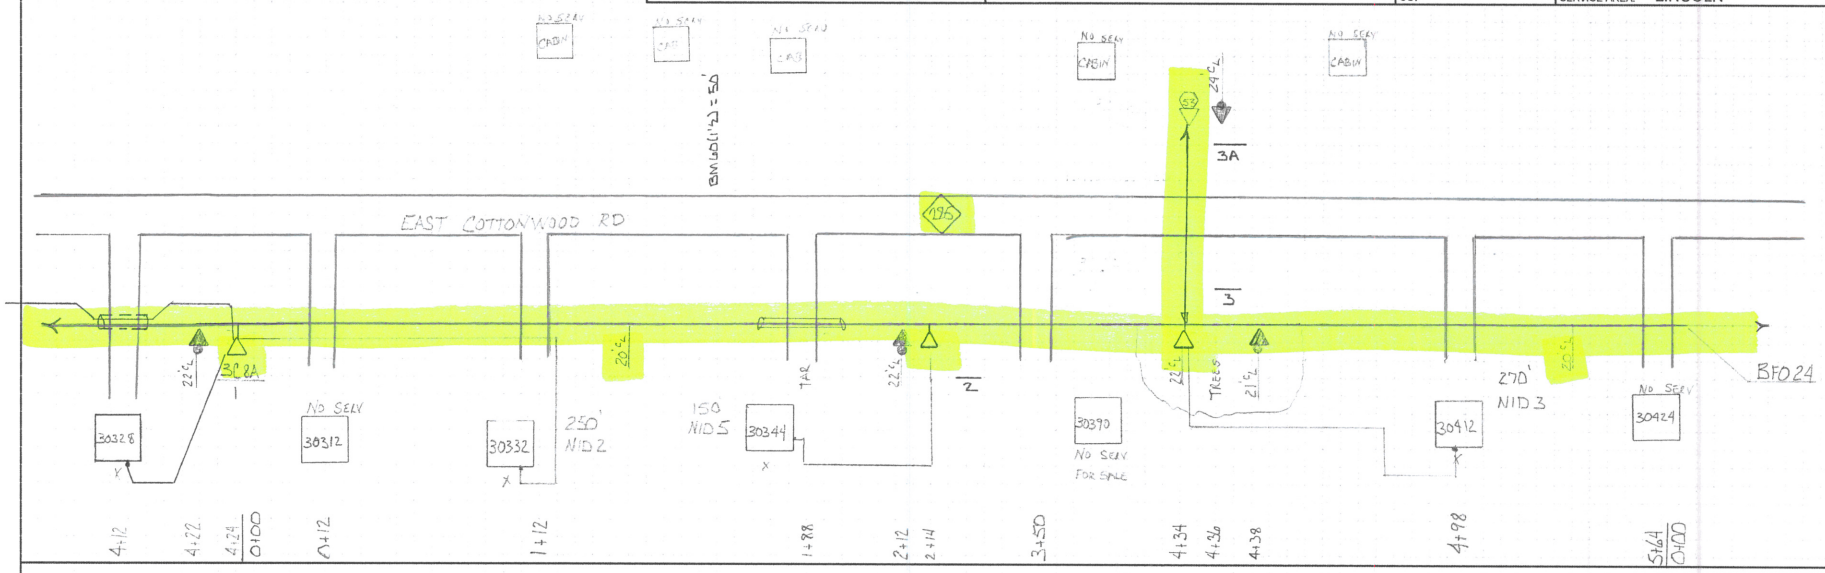

HOUSING NO.	BA	BDO		BFO		BH	BM			HBF		HO		NID		SUB NO.	SE		UD		UO		
		4 (5b)		24			2 (5/8x8)	53	60 (1½) P			1		3	5		B 4		(1x1-1½) A		24		
2		1		282			1		50			1			1	30344	150						
3		1		288			1					2		1		30412	270						
3A		1					1	1				END							78		122		
		3		570			3	1	50			3		1	1		420		78		122		

Prepared By: CNS 218-164-3000

DISTANCE FROM ℄ ROAD: SEE NOTATION	CTC	TWP 132 N	ROUTE: 3C 8A
STAKED BY: RE DATE: 8/11	PROJECT: MN537-2012	RNG 30 W	
REV. REV.	EXCHANGE: LINCOLN	SEC. 31	SHEET: 1 OF 3
AS BUILT BY: DATE:	TOWNSHIP: SCANDIA VALLEY	CO. MORRISON	SERVICE AREA: LINCOLN

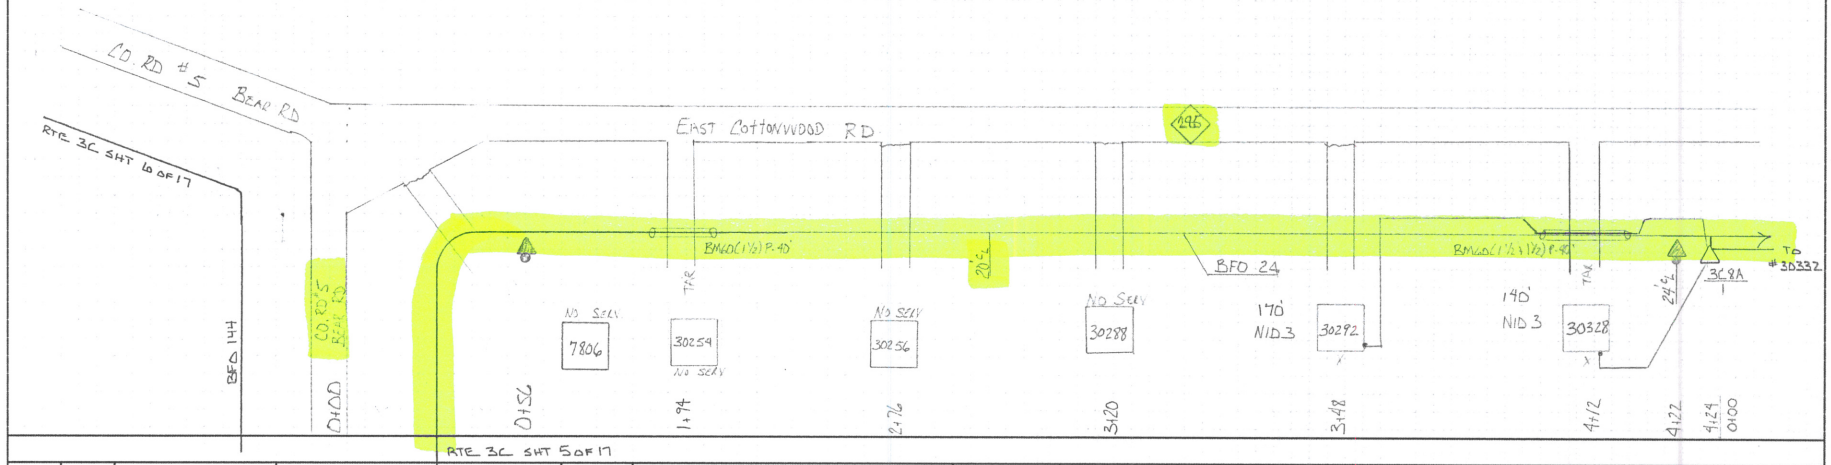

HOUSING NO.	BA	BDO		BFO		BH	BM			HBF	HO	NID		SUB NO.	SE	UD	UO
		4 (S6)		24			2 (S6)(8)	6D (1½) P	6D (1½+1½) P		1	2	3		B 4		
1		1		79D			1	4D	5D		3		1	30328	14D		
													1	30292	17D		
												1		30332	25D		
		1		79D			1	4D	5D		3	1	2		56D		

Prepared By CNS 218-564-3000